
FORM 51 10M 8-47 KANSAS Pratt O.W.W.O.

Section 26 Township 26 Range 13W

Well No. 1 Gobin

Company Tidewater

Carmi

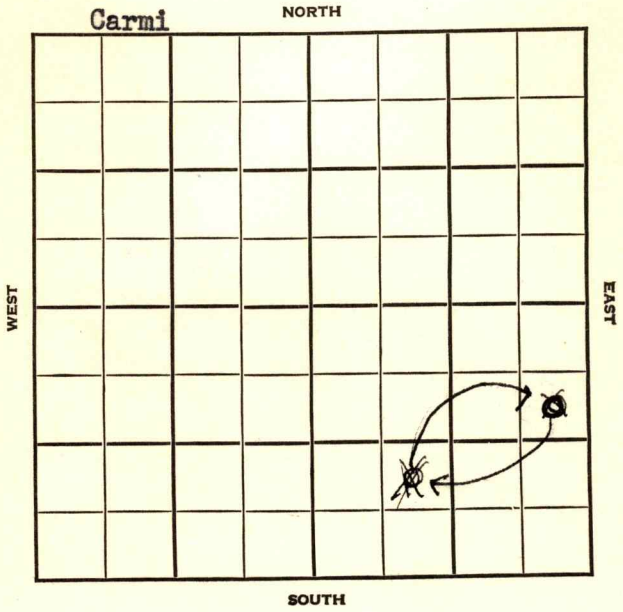

FORM 252-A
5M 9-47 PETROL

KANSAS O.W.W.O. Pratt

Sec. 26 Twp. 26 R. 13W

Well No. #1 Gobin Farm

Tidewater Company


Carmi Pool

~~990'~~ 990' Ft. from N. Line

~~990~~ Ft. from S. Line

~~330'~~ 330' Ft. from E. Line

~~990~~ Ft. from W. Line

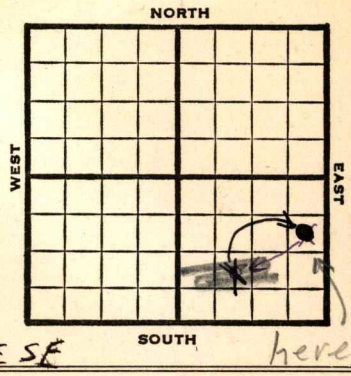

~~SE NE SE~~ ~~NE SE SE~~ SE NE SE here

1948	Elev. 1935' REPORT
3/3	Location
3/10	"
3/17	"
3/24	"
3/31	"
4/7	8" @ 800' Drlg. 3775'
4/14	Lansing 3715' Simpson Sand 4235' Drlg. 4241'
4/21	Arbuckle 4327' TD 4336' 5" @ 4334' RUST
4/28	TD 4350' 1700' oil 12 hrs.
5/5	"
5/12	"
5/19	"

OVER

1948

6/1 Arbuckle 4327'
5" @ 4334'
Pump 195 Pot.
Gr. 39.9°
TD 4350'

COMPLETED

1952 O.W.W.O.

3/19 Oil Well TD 4350
Lans. 3715' Simp sh. 4220
Simp. sd. 4235 Arb. 4327
OTD 4350 5" @ 4334
PB 4298 32/ 4254-62 SO
Hydro P/ 8 bo 4 BW 24 hr.
500 A
Comp. 105 bopd plus wtr.

FIRST REPORT
COMPLETED

FORM 275 FOR SALE BY KANSAS BLUE PRINT CO.


County Pratt State ~~Kansas~~

Sec. 26 (Blk. Twp.) 26 (Sur. Rge.) 13W Map No.

Operator Tidewater

Well No. 1 Farm Gobin

Elev. 1935 Location SE NE SE

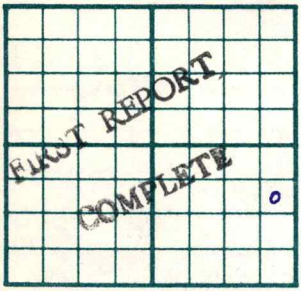

990 Ft. From N Line SE

330 Ft. From E Line Quarter

1st. Report MAR 19 1952

Completion MAR 19 1952

Remarks OWWO

O.W.W.O.

Spudding Date

Drlg. Data Oil well TD 4350

Lans. 3715 Simp. sh. 4220 Simp. sd. 4235

Arb. 4327 OTD 4350 5" @ 4334

PB 4298 32/ 4254-62 SO Hydro.

P/ 8 bo 4 bw 24 hr. 500 A

Comp. 105 bopd plus water

J. G. McGEHEE

Form 26—200 Bks.—1-48—Palace

Carmi Pool

Kansas

Map No. _____ Sec. 26 Twp. 26 R. 13W


Well No. 1 Gobin

Tidewater Company

FIRST REPORT Contractor

SE NE SE

SECTION PLAT

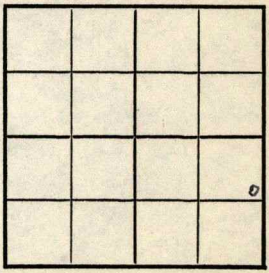

990 Ft. from N. Line

_____ Ft. from S. Line

330 Ft. from E. Line

_____ Ft. from W. Line

Pratt County

Location x

Rig up _____

Drilling and Remarks:

RECORD

Cased _____ in., _____ ft.

Sand _____

Gas _____

Oil _____

Total Depth _____

PRODUCTION

1st 24 hrs. Nat. _____

1st 24 hrs. after shot _____

Gas _____ Cu. Ft.

Dry Hole _____

Abandoned _____

Date

MAR 3 1948 19 S. J. LEWIS Scout

Form 26—200 Bks.—1-48—Palace

Carmi Pool

Kansas

Map No. 83 Sec. 26 Twp. 26 R. 13W

Well No. 1 Gobin

Tidewater Company

CORRECTION Contractor

SE NE SE


990 Ft. from N. Line

Ft. from S. Line

330 Ft. from E. Line

Ft. from W. Line

SECTION PLAT

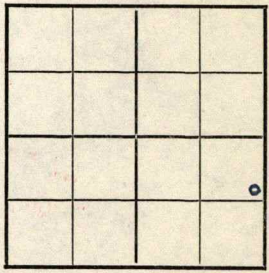

Pratt County

Location

Rig up

Drilling and Remarks:

Reported

NE SW SE

RECORD

Cased in., ft.

Sand

Gas

Oil

Total Depth

PRODUCTION

1st 24 hrs. Nat.

1st 24 hrs. after shot

Gas Cu. Ft.

Dry Hole

Abandoned

Date

MAY 26 1948 19 S. J. LEWIS Scout

Form 26—200 Bks.—1-48—Palace

Carmi Pool

Kansas

Map No. 83 Sec. 26 Twp. 26 R. 13W


Well No. 1 Gobin

Tidewater Company

CORRECTION Contractor

NE SW SE

SECTION PLAT

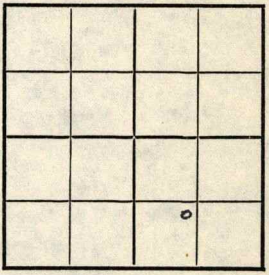

____ Ft. from N. Line

990 Ft. from S. Line

____ Ft. from E. Line

990 Ft. from W. Line

Pratt County

Location

Rig up

Drilling and Remarks:

Reported
SE NE SE

RECORD

Cased ____ in., ____ ft.

Sand

Gas

Oil

Total Depth

PRODUCTION

1st 24 hrs. Nat.

1st 24 hrs. after shot

Gas ____ Cu. Ft.

Dry Hole

Abandoned

Date

MAY 12 1948

19____ S. J. LEWIS Scout

Form 26—200 Bks.—1-48—Palace

Carmi Pool

Kansas

Map No. 83 Sec. 26 Twp. 26 R. 13W

Well No. 1 Gobin

Tidewater Company


COMPLETE

Contractor

SE NE SE

El. 1735

SECTION PLAT

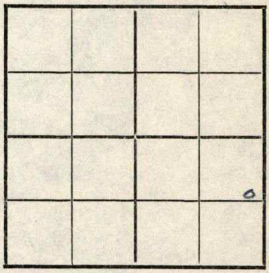

990 Ft. from N. Line

Ft. from S. Line

330 Ft. from E. Line

Ft. from W. Line

Pratt County

Location

Rig up

Drilling and Remarks:

Cir 8 4327

5" @ 4334

Pump 195 BO

RECORD

Cased in., ft.

Sand

Gas

Oil ✓

Total Depth 4350

PRODUCTION

1st 24 hrs. Nat.

1st 24 hrs. after shot

Gas Cu. Ft.

Dry Hole

Abandoned

Date

JUN 1 1948 19

S. J. LEWIS Scout