


Section 26 Township 26 Range 13W

Well No. 1 Hoener

Company Amerada Petr.

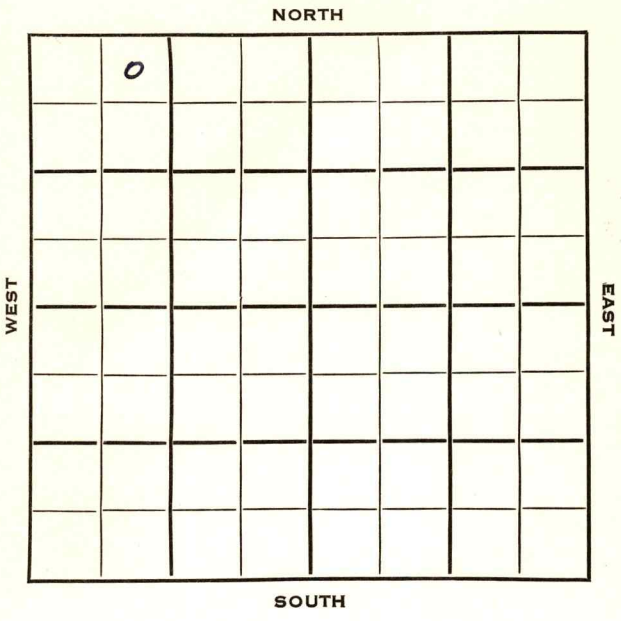


SEC. 26 TWP. 26 R. 13W

WELL NO. 1 Hoener FARM COMPANY

CONTRACTOR Amerada Petr.

NW Iuka-Carmi  
 330 Ft. from N. Line  
 Ft. from S. Line  
 Ft. from E. Line  
 990 Ft. from W. Line

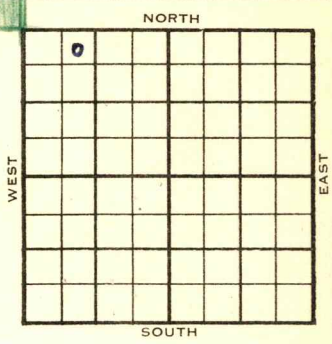

NE NW NW  
 MCPC has SE of 22

1954 ELEVATION REPORT

3/31 Location  
 4/7 "  
 4/14 "  
 5/1 Heebner 3568' Tor. 3585'  
 Douglas 3603' Douglas sand 3632'  
 Brown lime 3734' Lansing 3752'  
 DST 3783-3802, open 2 hrs rec 40'  
 slightly oil & gas cut water. BHP 0#  
 DST 3956-4005, open 2 hrs, rec 65'  
 slightly gas cut mud, BHP 110#  
 B KC 4079' Miss 4178' Kinderhook  
 4194' Viola 4210'  
 DST 4204-55, open 2 hrs, 30' gas cut  
 mud, 180' slightly oil & gas cut mud.  
 BHP 230# Simpson 4255'  
 DST 4252-91 open 2 hrs rec 1240' oil,  
 180' oil & gas cut mud, 90' gas cut  
 water. BHP 1240# G. 35.4  
 DST 4346-55 open 1 hr, 3' mud. BHP 0#  
 Arbuckle 4360'  
 DST 4355-65 open 1 hr weak blow for 15  
 mins. Died. Rec 10' mud.  
 DST 4360-70 open 1 hr rec 10' mud.  
 DST 4366-75 open 2 hrs, good blow 3000'  
 gas in pipe, rec 470' oil, 150' oil cut  
 mud, 50% oil. BHP 1250# Gv. 36.8  
 RTD 4375 Ran Sch. to 4371 5 1/2" @ 4365  
 (Ltr. McGehee)

**OVER**

1954

5/6

CO to 4375' S/15 $\frac{1}{2}$  BO 7 hr. 100  
mud-acid. S/14 BO 4 hr. S/20 $\frac{1}{2}$  BO  
7 hr. (Ltr-McGehee)

5/12

N.R.

5/19

"

5/27

P/8 BO plus 20 BW in 24 hrs.

P/4 BO + 21 BW in 24 hrs.

"

6/3

Completed for a pump test of  
12 BOPD + 21 BWPD

"

6/2

Oil well

TD. 4376

8 5/8" @ 799

Heeb 3568 Tor. 3585 Doug 3603

Doug.sd. 3632. Br. lime 3734

Lans. 3752

DST 3783-3803 open 2 hr.

Lans. 3752.

DST 3783-3802 open 2 hr.

Rec. 40' so & gcw Off.

DST 3956-4005 open 2 hr. Rec. 65'  
sgcm 110#

BKC 4079 Miss. 4178 Kh. 4194

Viola 4210

DST 4204-55 open 2 hr.

Rec. 30' gcm 180' so & gcm 230#

Simp 4255

DST 4252-91 open 2 hr.

REc. 1240 oil 180 o & gcm 90 gcw  
1240#

DST 4346-55 open 1hr. Rec. 3' mud  
Off

Arb. 4360

DST 4355-65 open 1 hr. Rec. 108 mud

DST 4360-70 open 1hr. Rec. 10' mud  
Off.

DST 4366-75 open 2 hr. 3000 gas in  
pipe 470 oil 150' ocm 50% oil  
1250#

TD. 4375

5" @ 4365

Schlumberger Tops

Heeb. 3568 Tor. 3585 Doug.sh. 3604

Doug. sd. 3632. Br. lime 3735

Lans. 3754 BKC 4080 Miss. 4172

Viola 4208 Simp. sh. 4257 Simp.dol

4264 Arb. 4360 CO to 4375

1954  
6/2

Hoener

TD 4376

S/15 $\frac{1}{2}$  bo 7 hr. 100 M-A S/14 bo  
4 hr. S/20 $\frac{1}{2}$  bo 7 hr.

P.8 bo 20 bwpd P/4 bo 21 bwpd

Comp. 12 bopd. 21bw

**COMPLETED**

~~ABANDONED~~

1954  
6/9

**O.W.W.O.**

OTD 4365' 5" @ 4365 Simp. dol. 4264

Simp. sd. 4276' Arb. 4360'

PB 4292' 20/4277-82 dry.

28/4266-73 B/17 GO  $\frac{1}{2}$  GW B/2 GOPH

1 GW. 2 hr. S/25 BO 12 hr. 250 M-A

250 A S/50 BO 50% wtr. 6 hr.

P/48 BOPD 41 BW

6/23

Oil Well

TD 4365

OTD 4365

5" @ 4365

Simp. dol. 4264 Simp. sd 4276

Arb. 4360 PB 4292

20/ 4277-82 dry 28/4266-73 B/ 17 go

$\frac{1}{2}$  gw B/2 goph 1 gw 2 hr. S/ 25 bo

12 hr. 250 M-A 250 A S/ 50 bo 50%

wtr. 6 hr. P / 48 bopd 41 bw Comp.

36 bopd 40 bw

**COMPLETED**

O.W.W.O.

County **Pratt** State **Kansas**

Sec. **26** (Blk. Twp.) **26** (Sur. Rge.) **13W** Map No.

Operator **Amerada Pet.**

Well No. **1** Farm **G. Hoener**

Elev. Location **NE NW NW**

0				

**330** Ft. From **N** Line **NW**  
**990** Ft. From **W** Line Quarter

Ist. Report **JUN 9 1954**

Completion

Remarks **O.W.W.O.**

Spudding Date **O.W.W.O.**

**FIRST REPORT**

Drlg. Data **NW Iuka-Carmi**

**OTD 4365 5" @ 4365 Simp. dol. 4264**  
**Simp. sd. 4276 Arb. 4360 PB 4292**  
**20/ 4277-82 dry 28/ 4266-73 B/ 17 go**  
**1/2 gw B/ 2 goph 1 gw 2 hr. S/ 25 bo**  
**12 hr. 250 M-A 250 A S/ 50 bo**  
**50% wtr. 6 hr. P/ 48 bopd 41 bw**

J. G. MCGEHEE

County **Pratt** State **Kansas**

Sec. **26** (Blk. Twp.) **26** (Sur. Rge.) **13W** Map No.

Operator **Amerada Pet.**

Well No. **1** Farm **Hoener**

Elev. Location **NE NW NW**

0					

**330** Ft. From **N** Line **NW**

**990** Ft. From **W** Line Quarter

1st. Report **MAR 21 1954**

Completion

Remarks **MCPC has SE of 22**

Spudding Date

Drlg. Data

**Location**

County Pratt State Kansas

Sec. 26 (Blk. 26) (Sur. Rge.) 13W Map No.

Operator Amerada Pet.

Well No. 1 Farm Hoener

Elev. 1942 Location NE NW NW

0					

330 Ft. From N Line NW  
990 Ft. From W Line Quarter

1st. Report

Completion JUN 2 1954

Remarks

Spudding Date

Drlg. Data Oil well TD 4376

8 5/8" @ 799 Heeb. 3568 Tor. 3585

Doug. 3603 Doug. sd. 3632 Br. lime 3734

Lans. 3752 DST 3783-3802 open 2 hr.

Rec. 40' so & gcw 0# DST 3956-4005

open 2 hr. Rec. 65' sgcm 110#

B KC 4079 Miss. 4178 Kh. 4194

Viola 4210 DST 4204-55 open 2 hr.

Rec. 30' gcm 180' so & gcm 230#

Simp. 4255 DST 4252-91 open 2 hr.

Rec. 1240' oil 180' o & gcm 90' gcw

1240# DST 4346-55 open 1 hr. Rec. 3'

mud 0# Arb. 4360 DST 4355-65

open 1 hr. Rec. 10' mud DST 4360-70

open 1 hr. Rec. 10' mud 0#

J. G. MCGEHEE

OVER

Drig. Data

DST 4366-75 open 2 hr. 3000' gas in pipe

470' oil 150' ocm 50% oil 1250#

TD 4375 5" @ 4365

SCHLUMBERGER TOPS

Heeb. 3568 Ter. 3585 Dougo sh. 3604

Doug. sd. 3632 Br. lms 3755 Lans. 3754

B KC 4080 Miss. 4172 Viola 4208

Simp. sh. 4257 Simp. dol. 4264 Arb. 4360

CO to 4375 TD 4376 S/ 15 1/2 bo 7 hr.

100 M-A S/ 14 bo 4 hr. S/ 20 1/2 bo 7 hr.

P/ 8 bo 20 bwpd P/ 4 bo 21 bwpd

Comp. 12 bopd 21 bw

Scout Cards  
 Land Small Map  
 Land Wall Map  
 Tracings  
 France Map  
 Pierce Map  
 Misc.

JUN 7 1954  
 [Signature]

O.W.W.O.

County Pratt State Kansas

Sec. 26 (Blk. 26) (Sur. Rge.) 13W Map No.

Operator Amerada Pet.

Well No. 1 Farm G. Hoener

Elev. Location NE NW NW

o					

330 Ft. From N Line NW

990 Ft. From W Line Quarter

1st. Report

Completion JUN 23 1954

Remarks OWWO

O.W.W.O.

Spudding Date

Drlg. Data Oil well TD 4365

OTD 4365 5" @ 4365 Simp. dol. 4264

Simp. sd. 4276 Arb. 4360 PB 4292

20/ 4277-82 dry 28/ 4266-73 B/ 17 go

1/2 gw B/ 2 goph 1 gw 2 hr. S/ 25 bo

12 hr. 250 M-A 250 A S/ 50 bo

50% wtr. 6 hr. P/ 48 bopd 41 bw

Comp. 36 bopd 40 bw