

Pratt KANSAS

Section 1 Township 26 Range 14W

Well No. #1 McCandless

Company Deep Rock & Rine Drlg. et al

NORTH

WEST

EAST

SOUTH

KANSAS 26

Pratt
R. 14-W

Sec. 1 Twp. R.

Well No. #1 McCandless Farm

Deep Rock & Rine Drlg. et al Company

Rine Drlg. Contractor

Moore


Ft. from N. Line

2310 Ft. from S. Line

Ft. from E. Line

330 Ft. from W. Line

NW of S $\frac{1}{2}$ of Lot 4
(logg section) Shell DHM

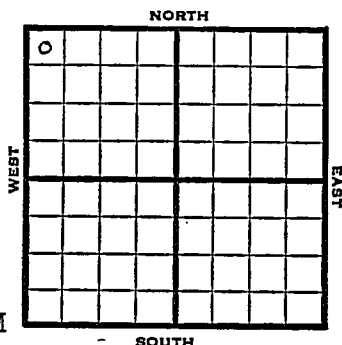

1950 Elev 1983 REPORT

10/18 Spud 10-13-50
8" @ 801
Drlg 1880

11/8 8" @ 801
Anhy 805-40 Lans 3782
DST 3932-49 opn 1 hr rec 25' socm
DST 3966-88 opn 1 hr rec 45' wcm
Viola 4297
DST 4297-4330 opn 1 hr rec 390' mud & wtr
Simp 4358 Sand 4362
DST 4350-75 rec mud
Arb 4427
DST 4429-78 opn 45 min rec 1695' sw
TD 4478
D&A

ABANDONED

County Pratt State KansasSec. 1 (Blk.) 26 (Sur.) 14W Map No. (Twp.) (Rge.)Operator Deep Rock & Rine Drlg. etal.Well No. 1 Farm McCandlessElev. 1983 Location NW of S $\frac{1}{2}$ of Lot 4

0							

2310 Ft. From S Line NW330 Ft. From W Line Quarter1st. ReportCompletion NOV 8 1950Remarks Moore PoolRine Drlg. - Contr.Spudding Date 10-13-50Drlg. Data D & A TD 44788" @ 801 Anhy 805-40 Lens. 3782DST 3932-40 open 1 hr. Rec. 25' socmDST 3966-88 open 1 hr. Rec. 45' wcmViola 4297 DST 4297-4330 open 1 hr.Rec. 390' mud & water Simp. 4358Sand 4362 DST 4350-75 Rec. mud Arb. 4427DST 4429-78 open 45 min. Rec. 1695' swTD 4478 D & A

J. E. TYRA