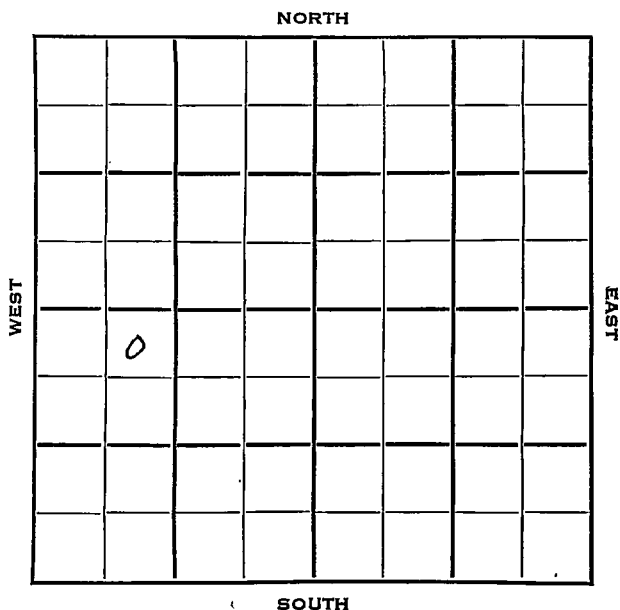



Section 1 Township 26 Range 1/WWell No. #1 WebsterCompany Lion Oil Company

Pratt

KANSAS

Sec. 1 Twp. 26 R. 11WWell No. #1 Webster FarmLion Oil Company CompanyRine Drlg. - Contr. Contractor
Moore Pool330 Ft. from N. Line Ft. from S. Line Ft. from E. Line990 Ft. from W. Line

NE NW SW

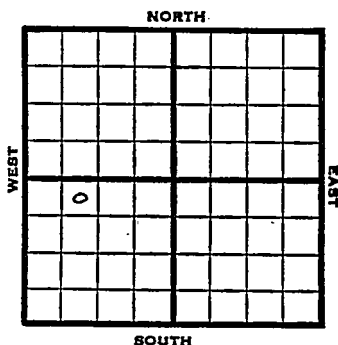

1953 Elev. 1977' REPORT

3/4 Spudded 2/27/53
8" @ 876

Drlg. 1985

3/12 Heeb 3613, Br li 3772, Lans
3801

3/18 Drlg. 3935'

Spud 2-27-53 D & A TD 4480'

8" @ 876 Heeb 3613' Br line 3772'

Lans 3801' Cong. 4211' Miss 4242'


DST 4208-49, open 1 hr. rec ~~25'~~

25' mud. Viola 4328' Simp. 4390'

Arb. 4475'

TD 4480' D & A

ABANDONED

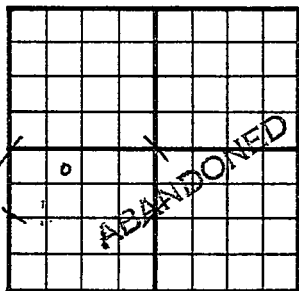County Pratt State KansasSec. 1 (Blk.
Twp.) 26 (Sur.
Rge.) 14W Map No.Operator Lion OilWell No. 1 Farm WebsterElev. 1977 Location NE NW SW330 Ft. From N Line SW990 Ft. From W Line QuarterIst. ReportCompletion MAR 18 1953Remarks Moore PoolRine Drlg. - Contr.Spudding Date 2-27-53Drlg. Data D & A TD 44808" @ 876 Heeb. 3613 Br. lime 3772Lans. 3801 Cong. 4211 Miss. 4242DST 4208-49 open 1 hr. Rec. 25' mudViola 4328 Simp. 4390 Arb. 4475TD 4480D & A

J. G. McGEHEE