


Section 1 Township 26 Range 14W

Well No. 1 Young

Company Deep Rock et al

Wildcat

NORTH

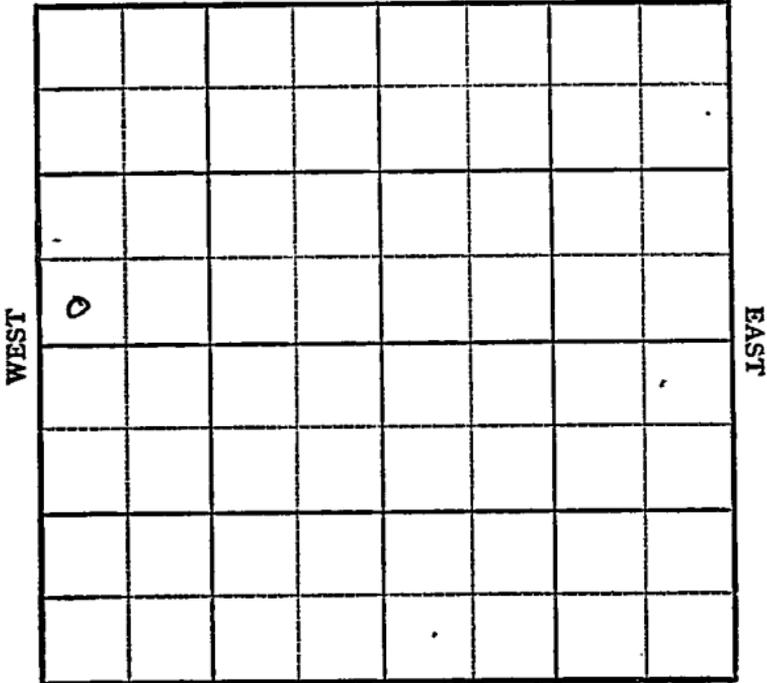

SOUTH

Sec. 1 Twp. 26 R. 14W ✓

Well No. #1 Young Farm

Deep Rock et al Company

Wildcat


_____ Ft. from N. Line

330' Ft. from S. Line

_____ Ft. from E. Line

330' Ft. from W. Line

SW NW

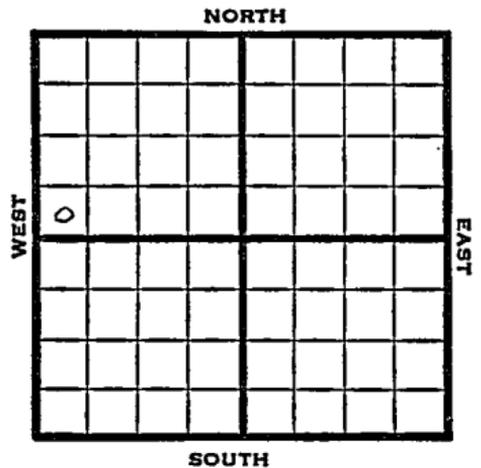

1948 Elev. 1982' REPORT

- 11/10 Drlg. 800'
- 11/16 8" @ 848'
Drlg. 3015'
- 11/23 Lansing 3778'
Cong 4210'
Drlg 4250'
- 11/30 Viola 4290'
Simpson Sd 4352'
Arbuckle 4418-45'
TD ~~4445'~~
5" @ 4420'
- 12/6 TD 4455' wtr.
- 12/14 Pump 40 bbls oil & 17 W - 24 hrs.
- 12/22 "
- 12/29 "
- 1/5 "
- 1/12 "
- 1/19 "
- 1/26 Simp sd 4352'
Arb. 4418'
5" @ 4420'
Perf Simp
Pump 40 oil & 10 W Pot.
Gr. 37.3°
TD 4455'

COMPLETED

Kansas

Map No. _____ Sec. 1 Twp. 26 R. 14WWell No. 1 Young

Deep Rock etal. _____ Company

FIRST REPORT

Contractor _____

SW NW

SECTION PLAT

_____ Ft. from N. Line

330 Ft. from S. Line

_____ Ft. from E. Line

330 Ft. from W. Line

Pratt County

Location _____

Rig up _____

Drilling and Remarks:

drlg. 800

RECORD

Cased _____ in., _____ ft.

Sand _____

Gas _____

Oil _____

Total Depth _____

PRODUCTION

1st 24 hrs. Nat. _____

1st 24 hrs. after shot _____

Gas _____ Cu. Ft.

Dry Hole _____

Abandoned _____

Date

NOV 10 1948

S. J. LEWIS

Scout

