


Section 3 Township 26 Range 14W

Well No. #1 Moore

Company Musgrove Pet.

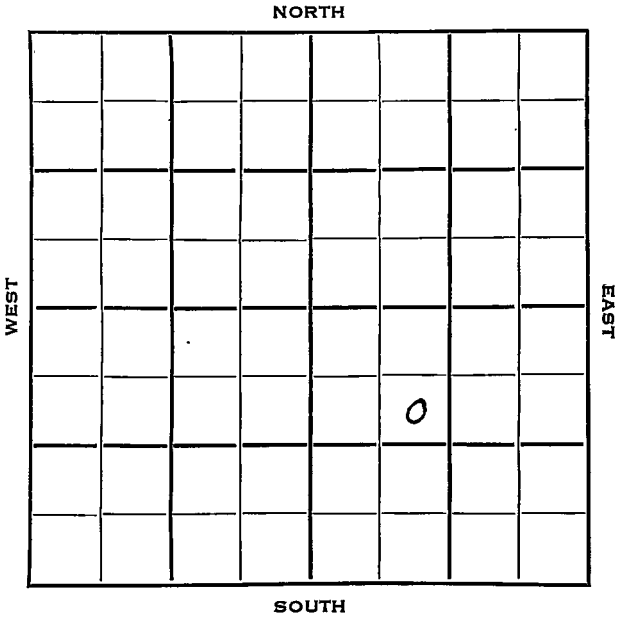

Sec. 3 Twp. 26 R. 1/W

Well No. #1 Moore Farm

Musgrove Pet. Company

Musgrove Contractor


**Wildcat.**

990 Ft. from N. Line

\_\_\_\_\_ Ft. from S. Line

\_\_\_\_\_ Ft. from E. Line

990 Ft. from W. Line

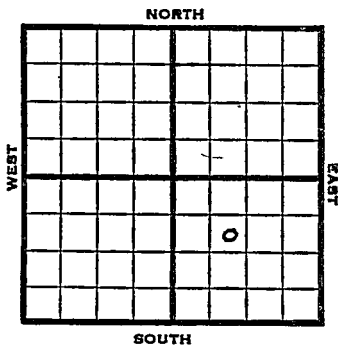

SE NW SE

1953 Elev. 1987' REPORT

7/29 Spud 6-27-53

8/5 8" @ 355'  
Drlg 3380'

8/12 Spud 7-27-53

D&A  
TD 3920  
8" @ 355'  
Heeb 3621, T or 3631, Br line 3781,  
Lans 3812  
TD 3920  
D&A

**ABANDONED**



