


DX 78-1

Section 2 Township 26 Range 14W

Well No. 1 Henderson

Company M. B. Armer

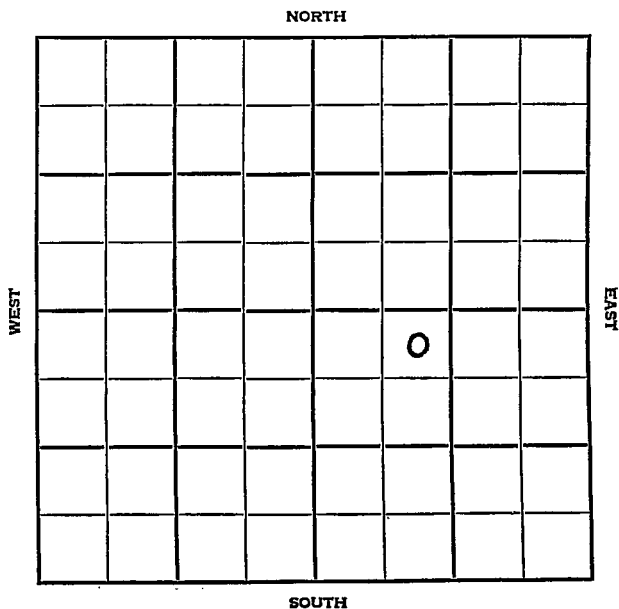

444

SEC.	TWP.	R.
2	26	11W

WELL NO.

1 Henderson

FARM

COMPANY

M. B. Armer

CONTRACTOR

Armer


Moore Pool

330 Ft. from N. Line

Ft. from S. Line

Ft. from E. Line

990 Ft. from W. Line

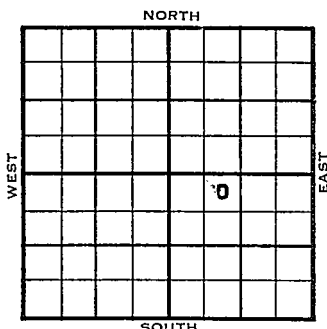

NE NW SE

Atl. Farmout

ELEVATION

REPORT

1954

1991'

8/4

Spud 7-23-54

8" @ 329'

Anhy 894', Heeb 3581', Tor 3593',

Doug. 3617', Br. Lime 3734', KC 3762'

DST 3806-20, opn 1 hr., rec. 85' OCM,

80' mud & gco, 400#

DST 3904'-11', opn 1 hr., rec. 840'

oil, 1300#

Drlg. 3956'

9/8

Spud 7-23-54

Oil Well

TD 4405'

8" @ 329'

Anhy 894', Heeb 3581', Tor 3593',

Doug 3617', Br. Lime 3734', KC 3762'

DST 3806'-20 opn 1 hr, rec 85' ocm,

80' mud & gc o 400#

DST 3904'-11' opn 1 hr, rec 840' oil

1300#

DST 3949'-56 6pn 1 hr, rec 95' wocm

1300# Miss 4171', Kh. 4185', Viola

4226',

DST 4230'-74' opn 40 min, rec 25' Mud

0#

OVER

1954

Information brought forward.

9/8

DST 4274'-4310' opn 40 min, rec 15'

Mud50# Simp 4325'

DST 4325'-53' opn 1 hr, rec 35' ocm,
360' gas, 75# Arb 4388'

TD 4405'

5" @ 4400'


72/ 4328'-40' sdfrac S/ $6\frac{1}{2}$ boph P/
97 bfpd. 35% Wtr.

dec. to 37 bfpd

Comp 279 bopd 4% Wtr.

COMPLETED


County Pratt State Kansas
 Sec. 2 (Blk.) 26 (Sur.) 14W Map No.
 Operator M. B. Armer
 Well No. 1 Farm Henderson
 Elev. 1991 Location NE NW SE

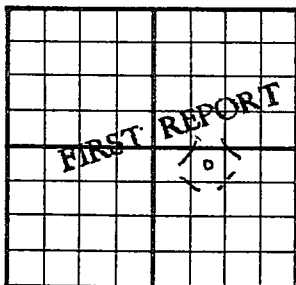

330 Ft. From N Line SE
990 Ft. From W Line Quarter
 Ist. Report AUG 4 1954
 Completion
 Remarks Atl. farmout
Armer - Contr.
 Spudding Date 7-23-54

Drlg. Data Moore Pool
8" @ 329 Anhy 894 Heeb. 3581
Tor. 3593 Doug. 3617 Br. lime 3734
KC 3762 DST 3806-20 open 1 hr. Rec.
85' oem 80' mud & gco 400# DST 3904-11
open 1 hr. Rec. 840' oil 1300#
drlg. 3956

U.G. McELITE

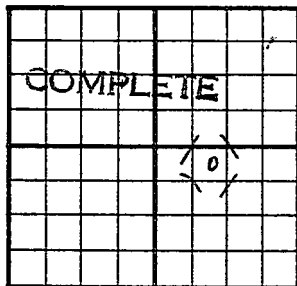County Pratt State KansasSec. 2 (Blk.
Twp.) 26 (Sur.
Rge.) 14W Map No.Operator M. B. ArmerWell No. 1 Farm HendersonElev. 1991 Location NE NW SE330Ft. From N Line SE990Ft. From W Line Quarter1st. Report SEP 8 1954

Completion

Remarks Moore PoolArmer - Contr.Spudding Date 7-23-54Drlg. Data Oil well TD 44058" @ 329 Anhy 894 Heeb. 3581Tor. 3593 Doug. 3617 Br. lime 3734KC 3762 DST 3806-20 open 1 hr. Rec.85' ocm 80' mud & gco 400# DST 3904-11open 1 hr. Rec. 840' oil 1300#DST 3949-56 open 1 hr. Rec. 95' woom1300# Miss. 4171 Kh. 4185 Viola 4226DST 4230-74 open 40 min. Rec. 25' mud0# DST 4274-4310 open 40 min. Rec.15' mud 50# Simp. 4325 DST 4325-53open 1 hr. Rec. 35' ocm 360' gas 75#Arb. 4388 TD 4405 5" @ 4400 72/ 4328-40sd-frac S/ 6 $\frac{1}{2}$ boph P/ 97 bfpd 35% wtr.dec. to 37 bfpd Comp. 279 bopd 4% wtr.

FABEN GILSTRAP