


Section 2 Township 26 Range 14 W

Well No. # 1 Henderson

Company Bishop Oil

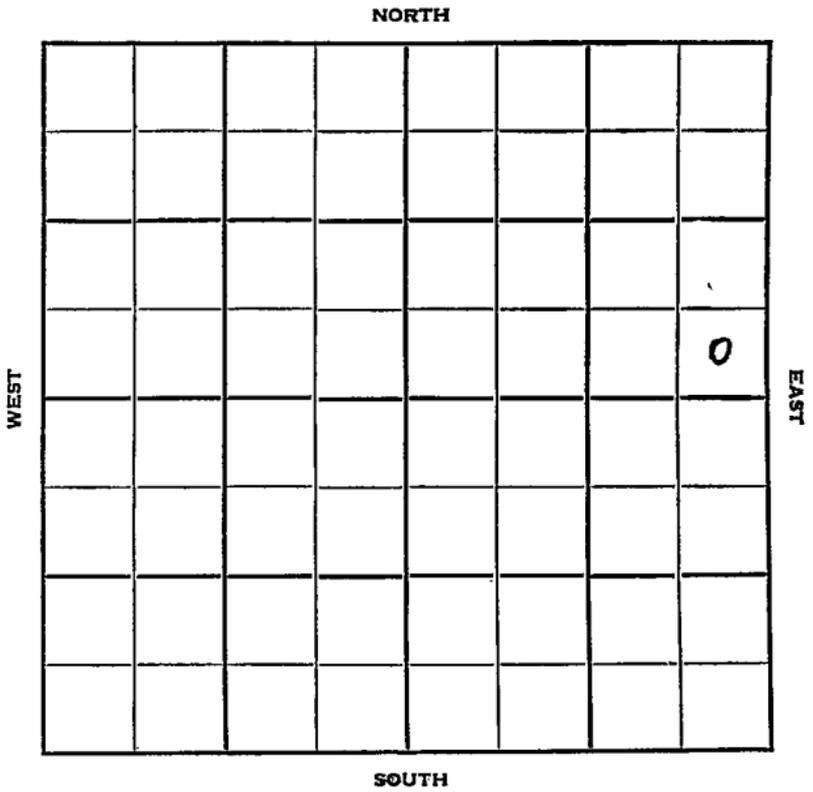

Sec. 2 Twp. 26 R. 11W

Well No. #1 Henderson Farm

Bishop Oil Company

Contractor


Moore Pool

Ft. from N. Line

330 Ft. from S. Line

330 Ft. from E. Line

Ft. from W. Line

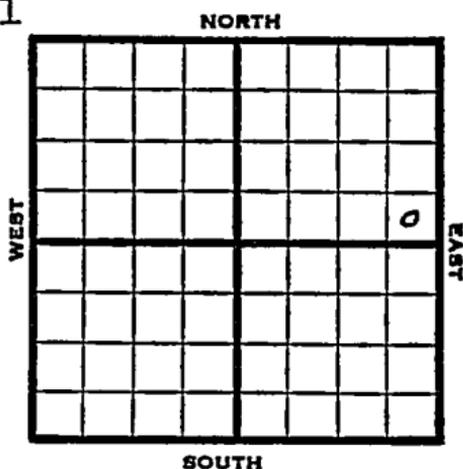

SE SE NE

1953 Elev. 1977' REPORT

- 6/17 Spud 6-12-53
8" @ 880'
WOC
- 6/4 Heeb 3574
Drlg. 3805'
- 7/1 Lans 3755
DST 3887-3900, 1/2 hr, 40' OGM
Cong 4150 Miss 4181
DST 4247-98, F/oil in 50"
Drlg. 4358'
- 7/8 V 4234 Simp 4292 Arb. 4351
RTD 4380 5" set CO
- 7/22 N.R.
- 7/29 Spud 6-12-53
Oil Well
TD 4380
8" @ 880
Heeb 3574, Lans 3755
DST 3887-3900, opn 1/2 hrs., rec. 40'
ocm,
Cong 4150, Miss 4181
DST 4247-98,
F/oil in 50",
Viola 4234, Simp 4292, Arb. 4351

OVER

(Information Brought Forward)

1953
7/29

TD 4380

5" ^W 4375

CO to 4380

DST 4296-4326, opn 1 hr., rec. 660'
gas, 120' gcm, 60/4234-444

F/35 bo 1 hr., dec to 6 bo 4th hr.

500A, F/96 bo 2 hrs.

Comp. 1596 bopd

COMPLETED

County Pratt State Kansas

Sec. 2 (Blk. 26) (Sur. 14W) Map No.

Operator Bishop Oil

Well No. 1 Farm Henderson

Elev. 1977 Location SE SE NE

330 Ft. From S Line NE

330 Ft. From E Line Quarter

Ist. Report

Completion JUL 29 1953

Remarks Moore Pool

Spudding Date 6-12-53

Drlg. Data Oil well TD 4380

8" @ 880 Heeb. 3574 Lans. 3755

DST 3887-3900 open 1/2 hr. Rec. 40' ocm

Cong. 4150 Miss. 4181 DST 4247-98

F/ oil in 50 min. Viola 4234 Simp. 4292

Arb. 4351 TD 4380 5" @ 4375 CO to 4380

DST 4296-4326 open 1 hr. Rec. 660' gas

120' gcm 60/ 4234-44 F/ 35 bo 1 hr.

dec. to 6 bo 4th hr. 500 A F/ 96 bo 2 hr

Comp. 1596 bopd