


Section 2 Township 26 Range 11W

Well No. 1 Webster

Company Bishop Oil

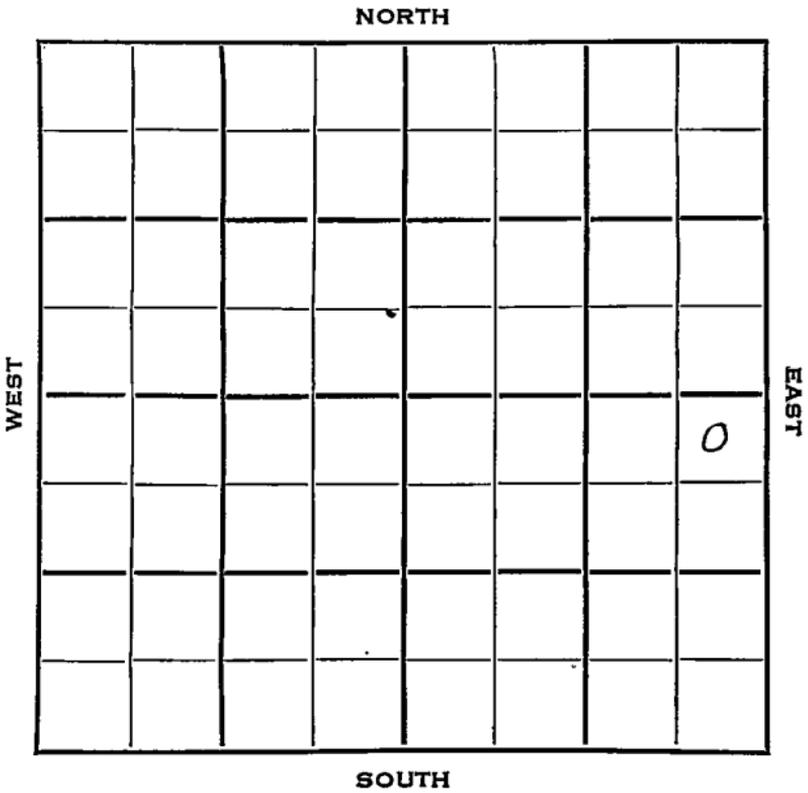

Pratt

KANSAS ✓

Sec. 2 Twp. 26 R. 14W

Well No. #1 Webster Farm

Bishop Oil Company

Rine Drlg. Contractor

Moore Pool

330 Ft. from N. Line


Ft. from S. Line

330 Ft. from E. Line

Ft. from W. Line

NE NE SE

Shell Farmout

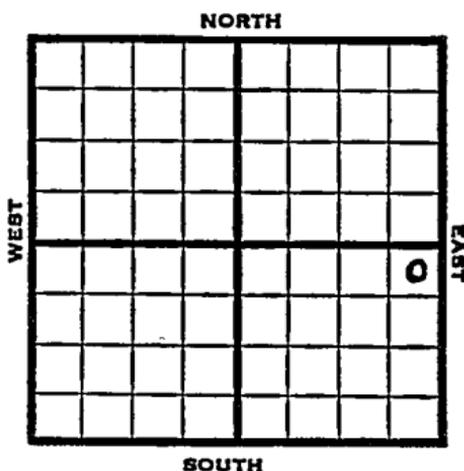

1953

Elev. 1982'

REPORT

|      |   |
|------|---|
| 4/8  | MIM   |
| 4/16 | Anhy 875<br>8" @ 881'<br>Drlg 2925'   |
| 4/23 | Drlg 4110'  |
| 4/30 | N.R.  |
| 5/7  | NR  |
| 5/21 | "   |
| 5/27 | Spud 4-9-53<br>Oil Well<br>TD 4393<br>Anhy 875<br>8" @ 881<br>Heeb 3583, Br lime 3734, Lans 3765<br>DST 3808-28, opn 1 hr., rec. 90'<br>ho & gcm, 2000' gas, 775#<br>DST 3844-60, opn 1 hr., rec. 180'<br>socm, 1075#<br>DST 3900-10, opn 1 hr., rec. 30'<br>socm, 90' muddy oil, 90' gco, 1035#<br>DST 3943-62, opn 1 hr., rec. 120'<br>g & wcm, 1230#<br>DST 3977-4000, opn 1 hr., gas in 36<br>mins., rec. 150' o & gcm, 90' mco,<br>975#<br>DST 4169-97, opn 1 hr., rec. 60' gcm<br>1090# |

OVER

#1 Webster  
(Information Brought Forward)

1953  
5/27

B KC 4072, Cong 4158, Miss 4181,  
Kh. 4204, Viola 4250  
DST 4237-87, opn 1 hr., rec. 3840'  
clean gco, 1320#  
Simp 4295  
DST 4290-4323, opn 1 hr., rec. 400'  
clean oil, 240' mco, 80' ocm, 975#  
Arb. 4360  
TD 4362,  
5" @ 4359  
DD 4393, 2 bwph, PB 4340  
68/4001-14, 18/4315-18, S/3½ boph  
14 hrs., 500A, S/4½ boph 14 hrs.  
A-frac -. S/15 boph  
Comp 609 bopd

**COMPLETED**




County Pratt State Kansas

Sec. 2 (Blk. Twp.) 26 (Sur. Rge.) 14W Map No.

Operator Bishop Oil

Well No. 1 Farm Webster

Elev. 1982 Location NE NE SE

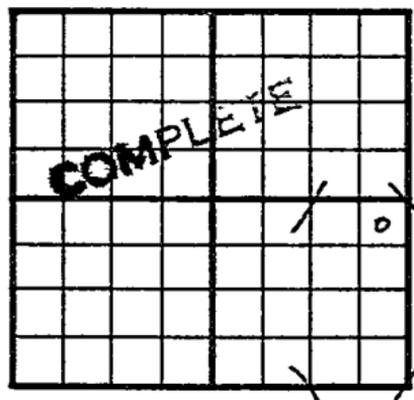

330 Ft. From N Line SE

330 Ft. From E Line Quarter

1st. Report

Completion MAY 27 1953

Remarks Moore Pool

Rine Drlg. - Contr.

Spudding Date 4-9-53

Drlg. Data Oil well TD 4393

Anhy 875 8" @ 881 Heeb. 3583

Br. lime 3734 Lans. 3765 DST 3808-28

open 1 hr. Rec. 90' ho & gcm 2000' gas

775# DST 3844-60 open 1 hr. Rec.

180' socm 1075# DST 3900-10

open. 1 hr. Rec. 30' socm 90' muddy oil

90' gco 1035# DST 3943-62 open 1 hr.

Rec. 120' g & wcm 1230# DST 3977-4000

open 1 hr. gas in 36 min. Rec. 150'

o & gcm 90' mco 975# DST 4169-97

open 1 hr. Rec. 60' gcm 1090#

B KC 4072 Cong. 4158 Miss. 4181

Kh. 4204 Viola 4250 DST 4237-87

open 1 hr. Rec. 3840' clean gco 1320#

Drlg. Data

Simp. 4295 DST 4290-4323 open Misc.

Rec. 400' clean oil 240' 80' ocm

975# Arb. 4360 TD 4362 359

DD 4393 2 bveh 4340 1-14

18/ 4315-18 500 A

S/ 4 1/2 boph 14 hr A-frac S/ 15 boph

609 bopd

NOF