


Section 2 Township 26 Range 11W

Well No. 2 Webster

Company Bishop Oil

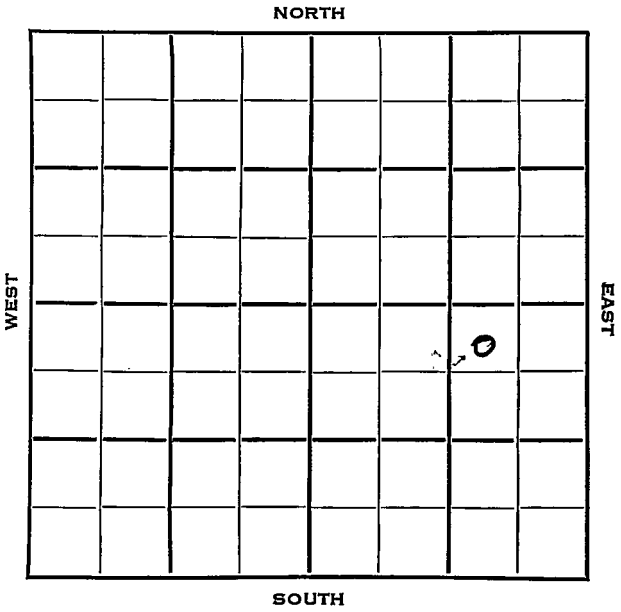

SEC.	TWP.	R.
2'	26	14W ✓

WELL NO. \_\_\_\_\_  
 2 Webster FARM

COMPANY \_\_\_\_\_  
 Bishop Oil

CONTRACTOR \_\_\_\_\_  
 Todd Drlg.


Moore Pool

330 \_\_\_\_\_ Ft. from N. Line

\_\_\_\_\_ Ft. from S. Line

990 \_\_\_\_\_ Ft. from E. Line

\_\_\_\_\_ Ft. from W. Line

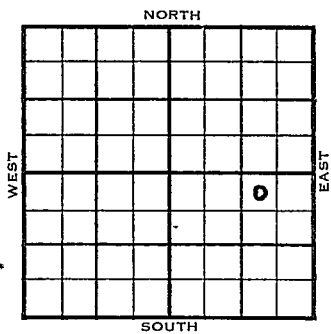

NW NE SE

1954	ELEVATION 1978'	REPORT
------	--------------------	--------

2/10 RWR  
 2/17 8" @ 882'  
 Drlg 3240'  
 2/24 Anhy 874', Heeb 3584'  
 Drlg 4253'  
 3/3 Br. L 3736', Lans 3756', Cong 4148'  
 Miss 4170', V 4223',  
 DST 4224'-43' 1 hr, F Clean oil in 47  
 mins, FP 630# 1290#  
 DST 4243'-65' 3/4 hr, F clean oil in 30  
 mins, FP 1020# 1480#  
 DST 4303'-34' 1 hr, 45' SOCM, 60' Hly  
 OCM, 300' clean oil 1040# Arb 4358'  
 RTD 4400  
 5" @ 4399'  
 3/10 64/ 4244-60 33 boph 5 hrs.  
 500' A F 50 boph 1" Ck.  
 Simp 4293'  
 3/24 Spud 2-8-54  
 Oil Well  
 TD 4400'  
 8" @ 882'  
 Anhy 874', Heeb 3574', Br. Lime 3726'

1954

Information brought forward.

3/24

Lans 3756', Cong 4148', Miss 4170'  
Viola 4222'

DST 4224'-43' opn 1 hr, F/ clean oil  
in 47 min

1290#

DST 4243'-65' opn 3/4 hr, F/ clean oil  
in 30 min, 1480#

DST 4303'-34' opn 1 hr, rec 45' socm  
60' hocom 300' clean oil 1040#

Arb 4358'

TD 4400'

5" @ 4399'

64/ 4244-60 Simp 4293'

33 boph 5 hr. 500 A

F/ 50 boph

Comp 2065 bopd.

**COMPLETED**



County Pratt State Kansas  
 Sec. 2 (Blk.) 26 (Sur.) 14W Map No.  
 Operator Bishop Oil  
 Well No. 2 Farm Webster  
 Elev. 1978 Location NW NE SE


330 Ft. From N Line SE990 Ft. From E Line Quarter

1st. Report

Completion MAR 24 1954Remarks Moore PoolTodd Drlg. - Contr.Spudding Date 2-8-54Drlg. Data Oil well TD 44008" @ 882 Anhy 874 Heeb. 3574Br. lime 3726 Lans. 3756 Cong. 4148Miss. 4170 Viola 4222 DST 4224-43open 1 hr. F/ clean oil in 47 min.1290# DST 4243-65 open 3/4 hr.F/ clean oil in 30 min. 1480# DST 4303-34 open 1 hr. Rec. 45' socm 60' hoem300' clean oil 1040# Arb. 4358TD 4400 5" @ 4399 64/ 4244-60Simp. 4293 33 boph 5 hr. 500 AF/ 50 boph Comp. 2065 bopd

J. G. MCGEHEE