

KANSAS

FORM 51 5M 4-41 PETROL

Pratt

Section 2 Township 26 Range 14-W

Well No. 1 Henderson

Company Skelly oil

Wildcat
NORTH

WEST

EAST

0

SOUTH

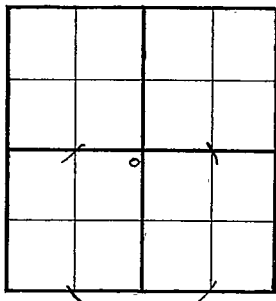
Map No. 83 Sec. 2 Twp. 26 R. 14WWell No. 1 HendersonSkelly Oil Company~~FIRST REPORT~~ Contractor

NE SW

330 Ft. from N. Line Ft. from S. Line330 Ft. from E. Line Ft. from W. Line

WILDCAT

SECTION PLAT

Location XRig up

Drilling and Remarks:

RECORD

Cased in., ft.Sand Gas Oil Total Depth

PRODUCTION

1st 24 hrs. Nat. 1st 24 hrs. after shot Gas Cu. Ft.Dry Hole Abandoned

Date

AUG 20 1941 19 S. J. LEWIS Scout

Map No. K83 Sec. 2 Twp. 26 R. 14WWell No. 1 HendersonSkelly Oil

Company

Contractor

ABANDONED

NE SW

330 Ft. from N. Line Ft. from S. Line330 Ft. from E. Line Ft. from W. Line

SECTION PLAT

	o		

WILDCAT

Location Rig up

Drilling and Remarks:

OK 4485Water.

RECORD

Cased in., ft.Sand Gas Oil Total Depth 4515

PRODUCTION

1st 24 hrs. Nat. 1st 24 hrs. after shot Gas Cu. Ft.Dry Hole Abandoned

Date

OCT 1 1941 19S. J. LEWIS Scout