


Pratt KANSAS

DX 78-1

Section 2 Township 26 Range 11W

Well No. 2 Wood

Company Armer Drlg.

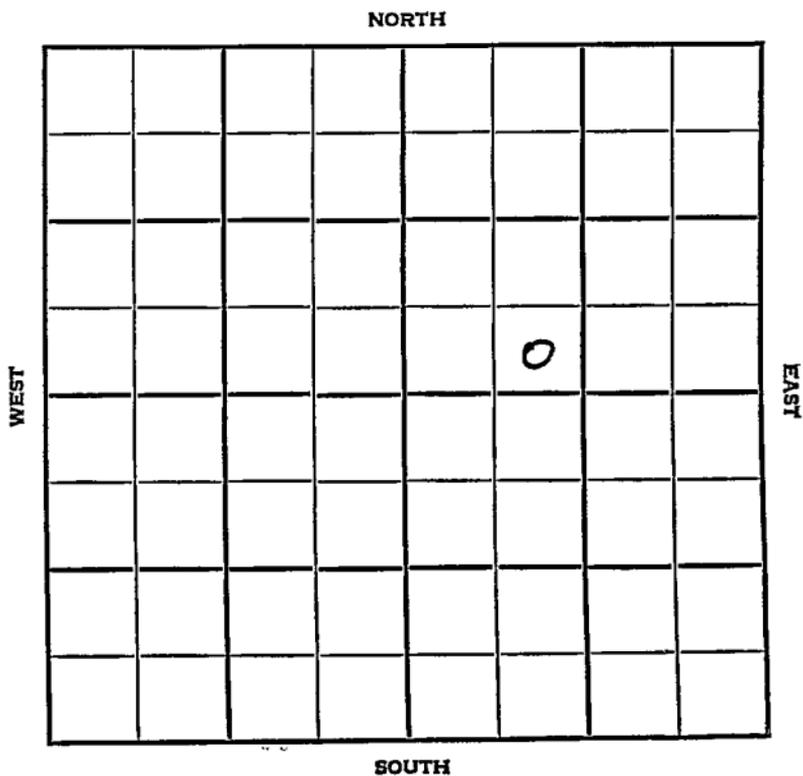

Pratt KANSAS


SEC.	TWP.	R.
2	26	14W

WELL NO. 2 Wood FARM

COMPANY Armer Drlg.

CONTRACTOR Co. tools

\_\_\_\_\_ Ft. from N. Line  
 330 \_\_\_\_\_ Ft. from S. Line  
 \_\_\_\_\_ Ft. from E. Line  
 990 \_\_\_\_\_ Ft. from W. Line

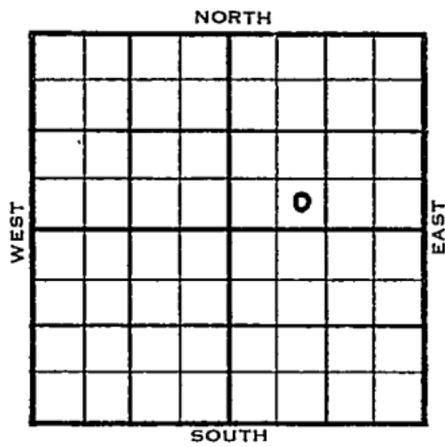

SE SW NE

1954	ELEVATION	REPORT
6/30	1979	M I R
7/7		Drlg. 3220
8-18		Spdg 6-29-54 Oil well TD 4391 8" @ 315 Anhy 890 Heeb 3574 Tor. 3584 Doug 3616 Br.lime 3731 Lans. 3760 DST 3784-3815 open 1 hr. Rec. 1500' gas 120' o & gcm 560# DST 3904 -20 open 1 hr. gas in 5 min Rec. 2105' oil 1250# DST 3945-61 open 1 hr. Rec. 130' sw 1300# Miss. 4167 Kh. 4182 Viola 4231 DST 4235-70 open 1 hr. Rec. 25' mud 55# Simp. 4319 DST 4320-45 open 1 hr. Rec. 300' gas 90' ocm 150# Arb. 4380 TD 4391 5" @ 4391 CO to 4350 78/ 4327-40 15 goph 250 M-A frac S/ 40 boph 6 hr. Comp. BHB 737 bopd
		<b>COMPLETED</b>



