


KANSAS

Pratt

Section 10 Township 26 Range 14W

Well No. #1 Henderson "B"

Company Champlin Refining Company

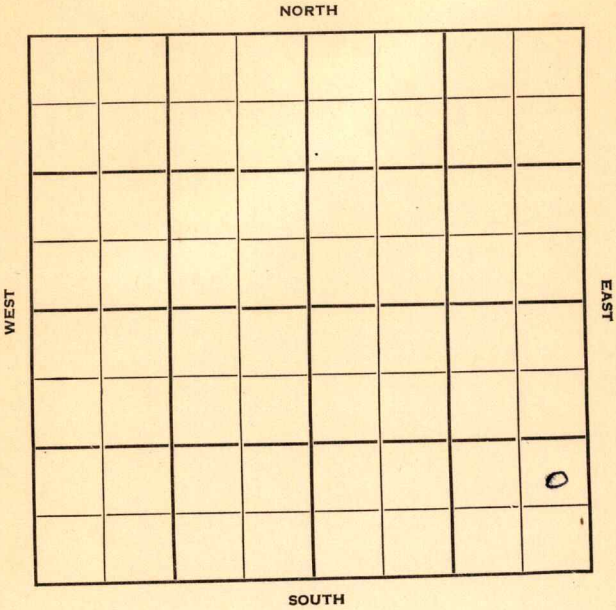

Pratt

KANSAS

Sec. 10 Twp. 26 R. 14WWell No. #1 Henderson "B" FarmChamplin Refining Company Company


Contractor

Ft. from N. Line

990 Ft. from S. Line330 Ft. from E. Line

Ft. from W. Line

NE SE SE

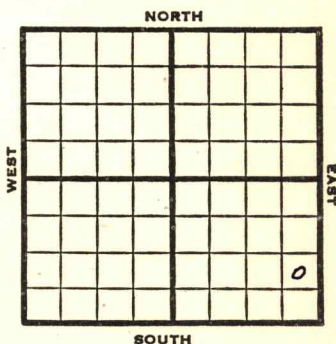

1953

Elev. 1992'

REPORT

3/18

Location

3/26

8" @ 889'

4/2

Drlg 3241'

4/9

Jeeb 3642, Br li 3791, Lans 3823

DST 3826-60, 1 hr., 90' SOCM, 1000#

DST 3896-3918, 1/2 hrs., 75' M, 1325#

DST 3957-71, 1 hr., 110' V SOCM, 525#

DST 4040-51, 40' mins., 25' M, 1215#

Drlg. 4064

4/16

Cong 4209

DST 4210-32 1 Hr. 595' gas, 33' M

550 # KH 4246

DST 4245-65 1 Hr. 120' Hg & socm

1425# V 4303

DST 4322-40 40' mins, 30' m

Simp sd 4425, Arb 4518,

TD 4538 Schl.

4/23

5" @ 4302'

4/30

N.R.

5/7

42/4246-52, 8 gfph, 5 goph + trace
Sd-frac

F 98 BO 12 hrs. + 1 M gas,

F 250 BO 36 hrs.

5/21

N.R.

OVER

#1 Henderson "B"

1953
5/27

Spud 3-21-53

OilWell

TD 4538

8" @ 889

Heeb 3642, Br lime 3791, Lans 3823

DST 3826-60, opn 1 hr., rec. 90'

socm, 1000#

DST 3896-3918, opn $\frac{1}{2}$ hrs., rec. 75'

mud, 1325#

DST 3957-71, opn 1 hr., rec. 110'

vsocm, 525#

DST 4040-51, opn 40 mins., rec. 25'

mud, 1215#

Cong 4269

DST 4210-32, opn 1hr., rec. 595' gas

33' mud, 550#

Kh 4246

DST 4245-65, opn 1 hr., rec. 120'

hg & socm, 1425#

Viola 4303

DST 4322-40, opn 40 mins., rec. 30'

mud,

Simp 4425, Arb. 4518

TD 4538

5" @ 4302

42/4246-52, 8 gfp

B/5 goph sd-frac

F/98 bo 12 hrs.

F/250 bo 36 hrs.

Comp F/237 bopd

COMPLETED

County Pratt State KansasSec. 10 (Blk. Twp.) 26 (Sur. Rge.) 14W Map No.Operator Champlin Ref.Well No. 1 Farm Henderson "B"Elev. Location NE SE SE

FIRST REPORT

990 Ft. From S Line SE330 Ft. From E Line Quarter1st. Report MAR 18 1953

Completion


Remarks

Spudding Date

Drlg. Data

Location

J. G. McGEHEE

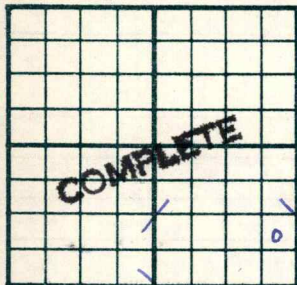County Pratt State KansSec. 10 (Blk. 26 (Sur. 14W Map No.)
(Twp.) (Rge.)Operator Champlin Ref.Well No. 1 Farm Henderson "B"Elev. 1992 Location NE SE SE990 Ft. From S Line SE330 Ft. From E Line Quarter1st. Report Completion MAY 27 1953Remarks Spudding Date 3-21-53Drlg. Data Oil well TD 4538

8" @ 889 Heeb. 3642 Br. lime 3791

Lans. 3823 DST 3826-60 open 1 hr.

Rec. 90' socm 1000# DST 3896-3918

open $\frac{1}{2}$ hr. Rec. 75' mud 1325#

DST 3957-71 open 1 hr. Rec. 110' vsocm

525# DST 4040-51 open 40 min. Rec. 25'

mud 1215# Cong. 4209 DST 4210-32

open 1 hr. Rec. 595' gas 33' mud

550# Kh. 4246 DST 4245-65 open 1 hr.

Rec. 120' hg & socm 1425# Viola 4303

DST 4322-40 open 40 min. Rec. 30' mud

Simp. 4425 Arb. 4518 TD 4538

5" @ 4302 42/ 4246-52 8 gfph B/ 5 goph

sd-frac F/ 98 bo 12 hr. F/ 250 bo 36 h

Comp. F/ 237 bopd

J. G. McGEHEE