

Section 11 Township 26 Range 14W

Well No. #1 Henderson

Company Champlin Ref.

NORTH

WEST

EAST

SOUTH

Pratt
26

KANSAS
14W ✓

Sec. 11 Twp. 26 R. 14W

Well No. #1 Henderson Farm

Champlin Ref. Company


Champlin
wildcat Contractor

990 Ft. from N. Line

Ft. from S. Line

990 Ft. from E. Line

Ft. from W. Line

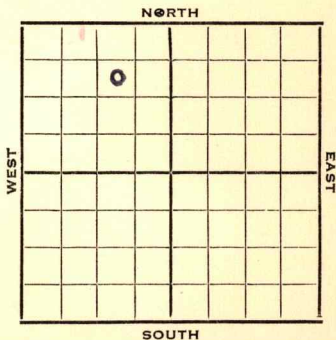

SW NE NW

1953 Elev. 1986' REPORT

2/25 MIR

2/26 RUR

3/12 8" @ 880 w/400

Anhy 890, Heeb 3604, Br 1i 3753,
Lans 3785

DST 3790-3821, 1 hr., 360' gas,
120' gcm, 255#

3/19 Drlg.

3/26 "

4/2 NR

4/9 NR

4/16 "

4/23 "

4/30 "

5/6 Spud 2-25-53

Oil Well

TD 4500'

8" @ 880'

Anhy 890', Heeb 3604', Br. Lime
3753', Lans 3785'

DST 3790-3821' opn 1 hr, rec 360'
gas, 120' gcm 255#

DST 3920-30 opn 1 hr, rec 1140' oil
1275#

DST 3994-4015 opn 1 hr, rec 240' gcm

OVER

1953

Information brought forward

5/6 1470#
B KC 4029', Cong 4179'
DST 4179-93 opn 1 hr, rec 30' mud,
1380# KH. 4214',
DST 4210-33 opn 1 hr, rec 155' hgcm
1400# Viola 4279,
DST 4273-87 opn 1 hr, rec 630' gas,
60' SO & GCM 375# Simp 4357'
DST 4356-65 opn 1 hr, gas in 38 min.
Rec 630' clean oil 1335#
DST 4366-80 opn 1 hr, rec 30' oil
2130' gcw 1000' sw 1300#
Arb 4450
DST 4455-4500 opn 1 hr, rec 2880' sul.
wtr. 1530#
TD 4500'
5" @ 4452'
10/ 4360-62 10/ 4362-64 20/ 4360-64
3/ 4364-65 3/ 4365-66
B/ 1½ bailers wtr. & ISO 6/ 4364-66
1¼ bailers oil & wtr. S/ 5 boph 16 hr
3% wtr. 18% mud P/ 50 bo 50 bw
Comp. 28 bopd 127 bw

COMPLETED

County Pratt State KansasSec. 11 (Blk.) 26 (Sur.) 14W Map No.Operator Champlin Ref.Well No. 1 Farm HendersonElev. 1986 Location SW NE NW

	0						

990 Ft. From N Line NW990 Ft. From E Line Quarter

1st. Report

Completion MAY 6 1953Remarks WildcatChamplin - Contr.Spudding Date 2-25-53Drilg. Data Oil well TD 45008" @ 880 Anhy 890 Heeb. 3604Br. lime 3753 Lans. 3785 DST 3790-3821open 1 hr. Rec. 360' gas 120' gcm255# DST 3920-30 open 1 hr. Rec. 1140'oil 1275# DST 3994-4015 open 1 hr.Rec. 240' gcm 1470# B KC 4029Cong. 4179 DST 4179-93 open 1 hr.Rec. 30' mud 1380# Kh. 4214DST 4210-33 open 1 hr. Rec. 155' hgcm1400# Viola 4279 DST 4273-87open 1 hr. Rec. 630' gas 60' so & gcm375# Simp. 4357 DST 4356-65 open 1 hr.gas in 38 min. Rec. 630' clean oil1335# DST 4366-80 open 1 hr.

J. G. McGEHEE

Drlg. Data

Rec. 30' oil 2130' gcw 1000' sw
1300# Arb. 4450 DST 4455-4500 open 1 hr
Rec. 2880' sul. wtr. 1530# TD 4500
5" @ 4452 10/ 4360-62 10/ 4362-64
20/ 4360-64 5/ 4364-65 3/ 4365-66
B/ 1½ bailers wtr. & SG 6/ 4364-66
1¼ bailers oil & wtr. S/ 5 boph 16 hr.
3% wtr. 18% mud P/ 50 bo 50 bw
Comp. 28' lpd 127 bw

COW

County **Pratt** State **Kansas**

Sec. 11 (Blk. Twp.) 26 (Sur. Rge.) 14W Map No.

Operator Champlin Ref.

Well No. 1 Farm Henderson

Elev.	Location	SW	NE	NW
-------	----------	----	----	----

0

FIRST REPORT

990 Ft. From N Line NW

990 Ft. From E Line Quarter

1st. Report FEB 25 1953

Completion

Remarks

Champlin - Contr.

Spudding Date _____

Drlg. Data Wildcat

MIR

J. G. McGEHEE