

KANSAS

Pratt

Section 14 Township 26 Range 14-WWell No. #1 MooreCompany Champlin Ref

Wildcat

NORTH

WEST

		0					

EAST

SOUTH

KANSAS

Pratt

Sec. 14 Twp. 26 R. 14W ✓Well No. 1 Moore Farm

Champlin Ref.


Company

Champlin Ref. Contr.

Wildcat NORTH

330 Ft. from N. Line Ft. from S. Line990 Ft. from E. Line Ft. from W. Line

NW NE SW

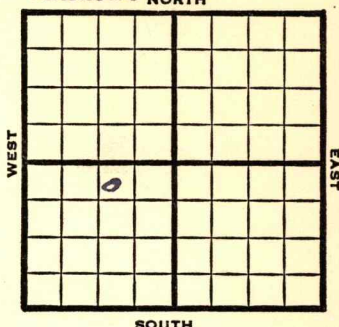

1949

Elev 1980'**REPORT**

7/27

Location

8/3

8" @ 865'

Drlg. 1400'

8/10

Drlg. 3025'

8/17

"

8/24

Miss. 4250'

Viola 4320'

Simpson 4408'

Arbuckle 4502'

TD 4535'

8/31

5" @ 4281'

9/7

"

9/14

"

9/21

36 qts 4278-98

Swb 26 bbls oil 24 hrs.

9/28

"

10/5

"Q

10/12

"

10/19

TD 4535'

Arb. 4502'

5" @ 4281'

Aband.

ABANDONED

Kansas

Wildcat

Map No. _____ Sec. 14 Twp. 26 R. 14WWell No. 1 Moore

Champlin Ref. _____ Company _____

Champlin Ref. _____ Contractor _____


NW NE SW

FIRST REPORT
SECTION PLAT330 Ft. from N. Line

_____ Ft. from S. Line

990 Ft. from E. Line

_____ Ft. from W. Line

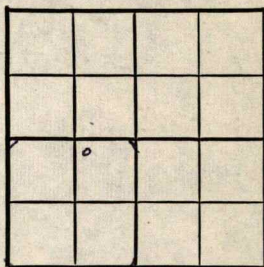

Pratt County

Location ✓

Rig up _____

Drilling and Remarks:

RECORD

Cased _____ in., _____ ft.

Sand _____

Gas _____

Oil _____

Total Depth _____

PRODUCTION

1st 24 hrs. Nat. _____

1st 24 hrs. after shot _____

Gas _____ Cu. Ft.

Dry Hole _____

Abandoned _____

Date

JUL 27 1949 19S. J. LEWIS Scout

Kansas

Map No. _____ Sec. 14 Twp. 26 R. 14WWell No. 1 Moore

Champlin Ref. _____ Company _____

ABANDONED

Contractor

NW NE SW

SECTION PLAT

330 Ft. from N. Line

_____ Ft. from S. Line

990 Ft. from E. Line

_____ Ft. from W. Line

	4		

Pratt County

RECORD

Location _____

Cased _____ in., _____ ft.

Rig up _____

Sand _____

Drilling and Remarks:

Gas _____

Oil _____

Total Depth 4535

PRODUCTION

1st 24 hrs. Nat. _____

1st 24 hrs. after shot _____

Gas _____ Cu. Ft.

Dry Hole _____

Abandoned _____

Date

OCT 19 1949

19

S. J. LEWIS

Scout