


Section 11 Township 26 Range 14 W

Well No. # 2 Moore "C"

Company Champlin Ref.

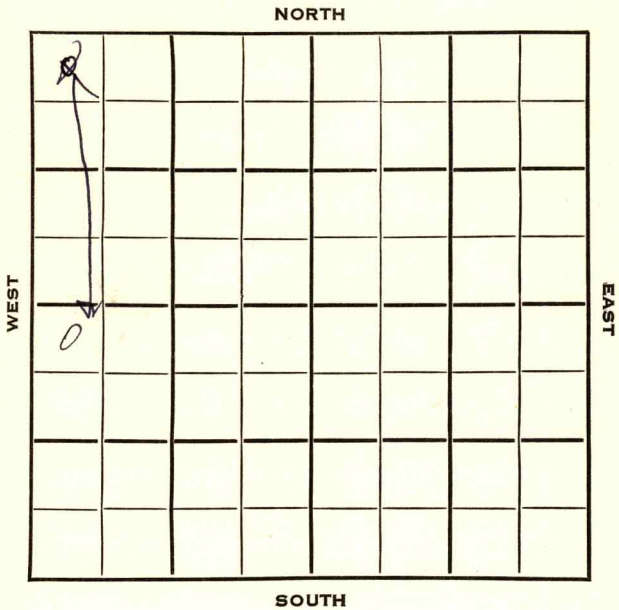

SEC.	TWP.	R.
11	26	14W ✓

WELL NO.

2 Moore "C"

FARM

COMPANY

Champlin Refg.

CONTRACTOR

Champlin


SW Moore Pool

330 Ft. from N. Line

Ft. from S. Line

Ft. from E. Line

330 Ft. from W. Line

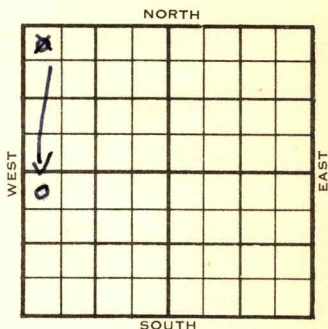

SW

NW NW ~~NW~~

ELEVATION

1953

1987'

REPORT

12/2
12/9RUR
8" @ 895'
Drlg. 2370'

12/16

Anhy 890'
Drlg 3911'1954
1/20

Spud 12-5-53
 SWD Well
 TD 5208'
 8" @ 895'
 Anhy 890', Heeb 3626', Tor 3644',
 Br lime 3778', Lans 3807'
 DST 3945-60', opn 1 hr., rec. 20' mud,
 Off
 B KC 4060', Cong. 4194', Viola 4290',
 Simp. 4394', Arb. 4489', Gr 5204'
 TD 5208'
 5" @ 5208'
 SP 4275, 48/4238-46
 Sd-frac, CO to 5208', 80/5037-57'
 100/5066-85, 1500A
 Comp. for SWD Well

ABANDONED

Kansas

Map No. _____ Sec. 11 Twp. 26 R. 14WWell No. 2 Moore "C"

Champlin Ref. _____ Company

CORRECTION

Contractor _____

NW NW SW

SECTION PLAT

330 Ft. from N. Line

_____ Ft. from S. Line

_____ Ft. from E. Line

330 Ft. from W. Line

Pratt County

Location _____

Rig up _____

Drilling and Remarks:

Reported

NW NW NW

RECORD

Cased _____ in., _____ ft.

Sand _____

Gas _____

Oil _____

Total Depth _____

PRODUCTION

1st 24 hrs. Nat. _____

1st 24 hrs. after shot _____

Gas _____ Cu. Ft.

Dry Hole _____

Abandoned _____

Date

DEC

9 1953 19

J. G. McGEHEE

Scout

County Pratt State KansasSec. 11 (Blk. 26 (Sur. 14W Map No. 11) (Twp. 26 (Rge. 14W)Operator Champlin Ref.Well No. 2 Farm Moore "C"Elev. Location NW NW NW

0							

330 Ft. From N Line NW330 Ft. From W Line Quarter1st. Report DEC 2 1953Completion Remarks Champlin - Contr.Spudding Date Drlg. Data SW Moore PoolR U R

