
FORM 51

Pratt KANSAS

Section 14 Township 26 Range 14W

Well No. 1 ~~Moore~~ Mary (Mary Moore)

Company Champlin Ref.

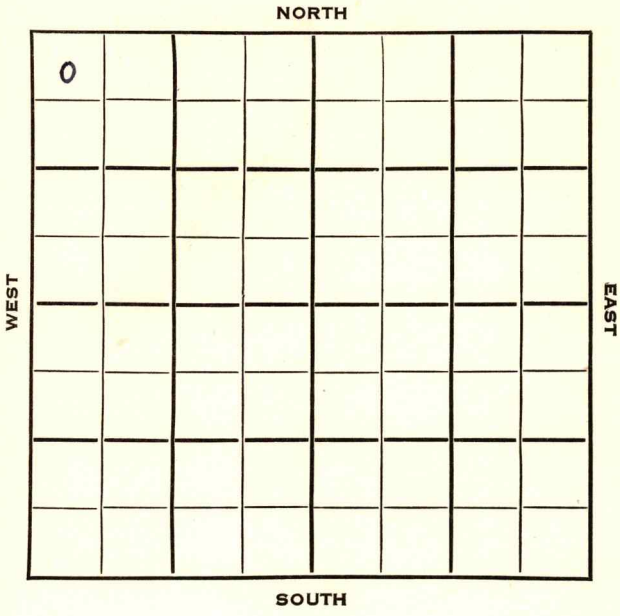

Pratt

KANSAS

SEC.	TWP.	R.
14	26	14W

WELL NO.

#1 ~~Moore~~ MARY FARM

COMPANY

Champlin Ref.

CONTRACTOR

Champlin


330 Ft. from N. Line

Ft. from S. Line

Ft. from E. Line

330 Ft. from W. Line

NW NW NW

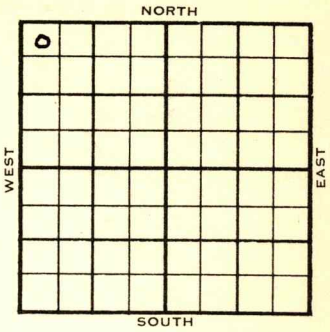

1953	ELEVATION 1985'	REPORT
11/11		R U R
11/18		8" @ 912'
		Drlg 2780'
12/30		Spud 11-11-53
		Oil Well
		TD 4370
		8" @ 912
		Heeb 3642, Br lime 3795', Lans 3825',
		B KC 4081', Ch. Cong 4250'
		DST 4251-66', opn 1 hr., rec. 30'
		gcm, 0#
		Kh. 4293'
		DST 4295-4306', opn 1 hr., rec. 30'
		mud, 195#
		TD 4370
		Viola 4346'
		5" @ 4366
		16/4292-96
		Sd-frac, 250A
		S/78 bf 17 hrs.
		S/72 bf 5% wtr, 21 hrs.
		Comp. 94 bopd

COMPLETED

DX-78

FORM 275 FOR SALE BY KANSAS BLUE PRINT CO.


County Pratt State Kansas

Sec. 14 (Blk. Twp.) 26 (Sur. Rge.) 14W Map No.

Operator Champlin Ref.

Well No. 1 Farm Moore

Elev. Location NW NW NW

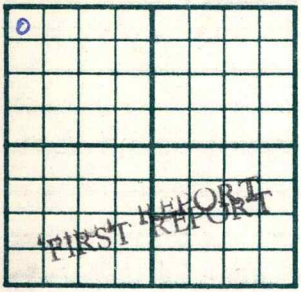

330 Ft. From N Line NW

330 Ft. From W Line Quarter

1st. Report NOV 11 1953

Completion

Remarks Champlin - Contr.

Spudding Date

Drlg. Data

R U R

J. G. McGEHEE

FORM 26 200 BKS. 4-52 PETROL

Kansas

Map No. _____ Sec. 14 Twp. 26 R. 14W


Well No. 1 Mary

Champlin Ref. Company

CORRECTION Contractor

NW NW NW

SECTION PLAT

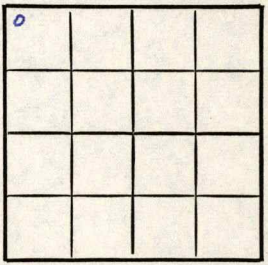

330 Ft. from N. Line

_____ Ft. from S. Line

_____ Ft. from E. Line

330 Ft. from W. Line

Pratt County

Location _____

Rig up _____

Drilling and Remarks:

Reported
#1 Moore

RECORD

Cased _____ in., _____ ft.

Sand _____

Gas _____

Oil _____

Total Depth _____

PRODUCTION

1st 24 hrs. Nat. _____

1st 24 hrs. after shot _____

Gas _____ Cu. Ft.

Dry Hole _____

Abandoned _____

Date

NOV 18 1953 19

J. G. McGEHEE Scout

FORM 275 FOR SALE BY KANSAS BLUE PRINT CO.

County Pratt State Kansas

Sec. 14 (Blk. Twp.) 26 (Sur. Rge.) 14W Map No.

Operator Champlin Ref.

Well No. 1 Farm Mary

Elev. 1985 Location NW NW NW



330 Ft. From N Line NW

330 Ft. From W Line Quarter

1st. Report

Completion DEC 30 1953

Remarks

Champlin - Contr.

Spudding Date 11-11-53

Drlg. Data Oil well TD 4370

8" @ 912 Heeb. 3642 Br. lime 3795

Lans. 3825 B KC 4081 Ch. Cong. 4250

DST 4251-66 open 1 hr. Rec. 30' gcm

0# Kh. 4293 DST 4295-4306 open 1 hr.

Rec. 30' mud 195# TD 4370 Viola 4346

5" @ 4366 16/ 4292-96 sd-frac 250 A

S/ 78 bf 17 hr. S/ 72 bf 5% wtr. 21 hr.

Comp. 94 bopd

J. G. McGEHEE