


Pratt

KANSAS

SECTION 28 TOWNSHIP 26S RANGE 14W

WELL NO. #1 Thompson

COMPANY # K & E & Musgrove

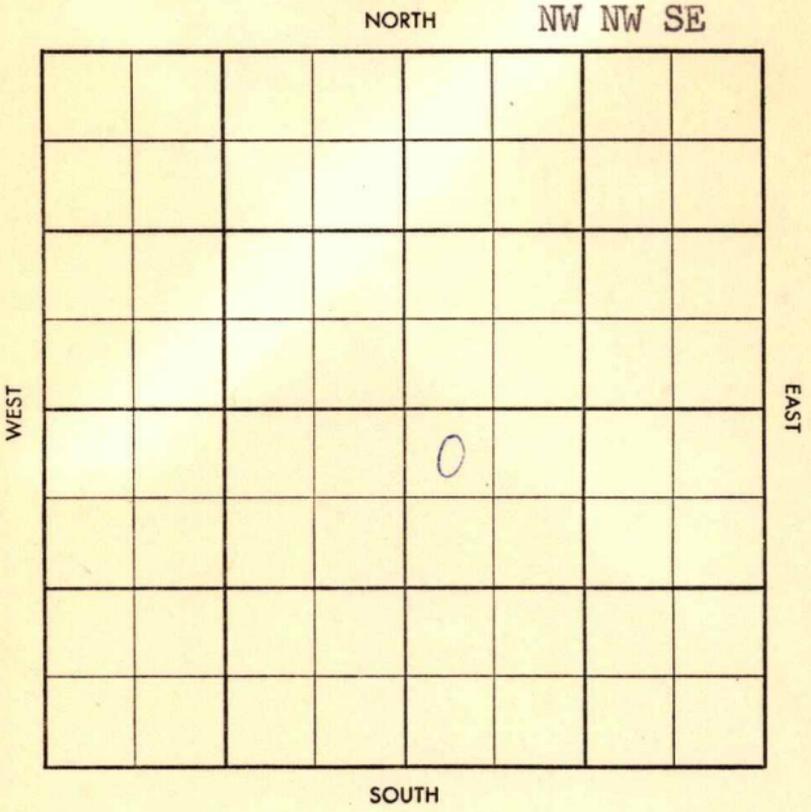

| | | |
|------------|--------------|------------|
| SEC. 28 | TWP. 26 S | R. 14 W |
|------------|--------------|------------|

WELL NO. # 1 Thompson FARM

COMPANY K & E & Musgrove

CONTRACTOR K & E Drlg. tools


Wildcat

_____ FT. FROM N. LINE

_____ FT. FROM S. LINE

_____ FT. FROM E. LINE

_____ FT. FROM W. LINE

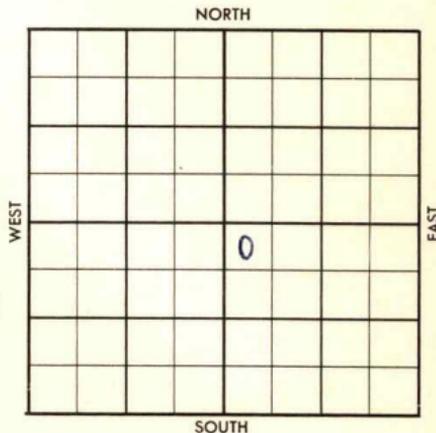

NW NW SE

SDX-1/4 Mile

| | | |
|------|-----------|--------|
| 1957 | ELEVATION | REPORT |
|------|-----------|--------|

10/2 Location (FR Tkt)

CO. ~~Pratt~~ ELEV ~~2002~~

ABANDONED

SEC. ~~28~~ TWP. ~~26~~ RGE. 14W

COMPANY ~~K. & E. &~~ NO. 1

OCT 16 57

~~1/4~~ MILE

Musgrove

Bank D & M

FARM Thompson

LOC. NW NW SE

| |
|--------------|
| H 3755 |
| TR 3780 |
| DG 3801 |
| B1 3884 |
| L 3912 |
| M chert 4360 |
| M Li 4382 |
| U 4455 |
| S 4538 |
| A 4636 |

GEOL. _____

CONTR. K&E Drlg. tools

POOL Wildcat

SPUD 10-3-57

Location OCT 9 57

8" 388/ ~~7385~~

3550 OCT 15 57

TD 4684 *run log*

Log Loss D & A

L 3912 M chert 4381

U 4458 S 4538 A 4632

CO.
NO.
SEC.
TWP.
RGE.