


KANSAS

Kearny County

Section 14 Township 26 Range 35W

Well No. #1 Citizens Bldg. & Loan

Company Helmerick & Payne

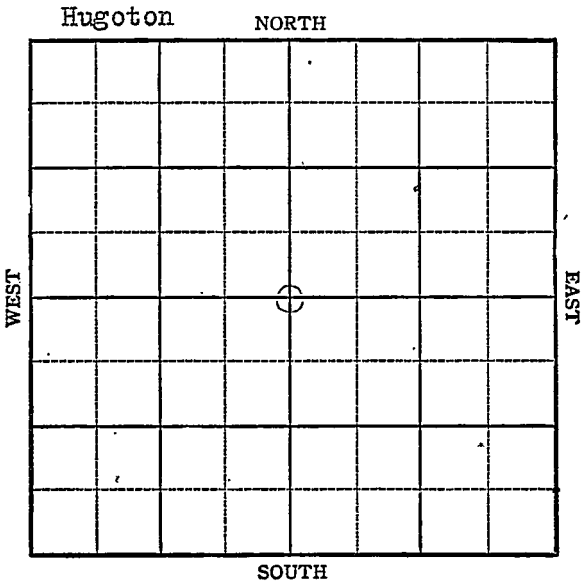

KANSAS

Kearny County

Sec. 14 Twp. 26 R. 35W

Well No. #1 Citizens Bldg & Loan Farm

Helmerick & Payne Company

Hogoton


2640 Ft. from N. Line

 Ft. from S. Line

 Ft. from E. Line

2640 Ft. from W. Line

C Sec. ELEV. 3000

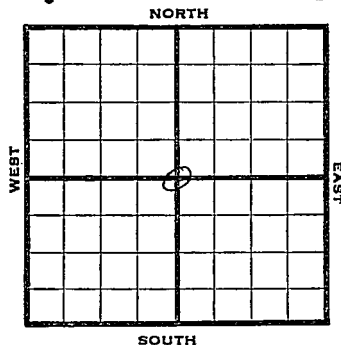

1944	R E P O R T
10/25	10" @ 760' WOC
11/1	Drlg. 2000
11/8	7" @ 2736 RUST
11/16	" " " "
11/24	" " " "
11/29	18 shots 2716-2724 1000 acid
12/6	TD 2740
12/14	" B"
12/21	" "
12/29	84 shots 2514-2716
	23000 acid.
<u>1945</u>	
<u>1/3</u>	" " "
1/10	" " "
1/17	" " "
1/28	" " "
1/31	" " "
2/7	" " "
2/14	" " "
2/21	7" @ 2786
	23000 acid
	TD 2736
	14,752,000 Gas
	421# R Pr.
	COMPLETED

Pool Name HugotonMap No. 14 Sec. 14 Twp. 26 R. 35WWell No. 1 Citizens Bldg & LoanHelmerick & Payne Company

FIRST REPORT

Contractor


C SEC

SECTION PLAT

2640 Ft. from N. Line

_____ Ft. from S. Line

_____ Ft. from E. Line

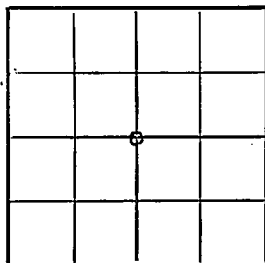2640 Ft. from W. LineKearny

RECORD

Location _____

Cased _____ in., _____ ft.

Rig up _____

Sand _____

Drilling and Remarks:

Gas _____

10"-760' WOC

Oil _____

Total Depth _____

PRODUCTION

1st 24 hrs. Nat. _____

1st 24 hrs. after shot _____

Gas _____ Cu. Ft.

Dry Hole _____

Abandoned _____

Date

OCT 25 1944 19S. J. LEWIS


Scout

Pool Name HugotonMap No. NM Sec. 14 Twp. 26 R. 35WWell No. 1 Citizens Bldg. & LoanHelmerick & Payne CompanyCOMPLETED

Contractor

C Sec.

SECTION PLAT

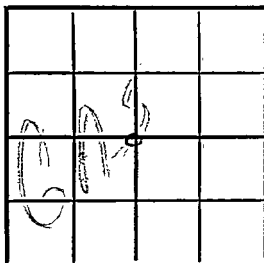2640 Ft. from N. Line Ft. from S. Line Ft. from E. Line2640 Ft. from W. LineKearnyLocation Rig up

Drilling and Remarks:

7 "C278623000 acal14, 752, 000 Gall421 # R Pz

RECORD

Cased in., ft.Sand Gas Oil Total Depth 2736

PRODUCTION

1st 24 hrs. Nat. 1st 24 hrs. after shot Gas Cu. Ft.Dry Hole Abandoned

Date

FEB 21 1945 19S. J. LEWIS

Scout