


Kerney

KANSAS

SECTION 14 TOWNSHIP 26 S RANGE 35 W

WELL NO. # 1-14 U.S.A.

COMPANY Helmerich & Payne

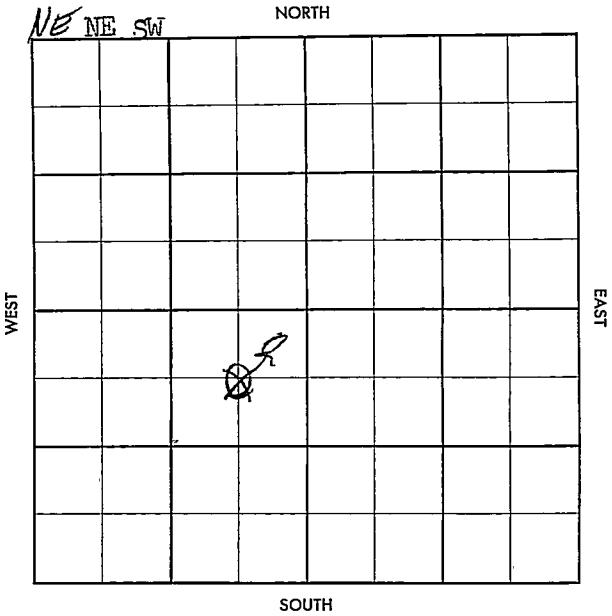

County Kearny Elev. _____
Sec. 14 Twp. 26 Rge. 35W
Company Heimerich & Payne
FarmName U. S. A. No. 1-14


TOPS	DEPTH	LOG	DATUM
Anh.			
TP.			
H.			
Tr.			
Dg.			
BL.			
L.			
K.C.			
B.K.C.			
Ce.			
C.			
M.			
M.			
K.			
Mz.			
Mo.			
V.			
S.			
S.			
A.			
R.			
Pe.			
G.			
T.D.			

Loc. in Sec. _____
NE SW

Geol. _____
Contr. McKnab & Lindsey Tools
Pool _____
Southside

FIRST REPORT	
•	
AUG 28 '57	

Date Comm. 8/20/57
10" @ 852 w/600, drlg 2775 (Miss)

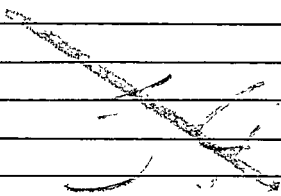

34

CONNECTION

FORM 513 SUNRAY

County KearnyElev. 3003 DFSec. 14Twp. 26Rge. 35WCompany Hennerich & PayneFarmName U. S. A.No. 1-14

TOPS	DEPTH	LOG	DATUM	Loc. in Sec.
Anh.				
TP.		3406		NENE SW
H.	3925	3825		
Tr.		3840		
Dg.				
BL.				
L.				
K.C.	3914	3913		Geol.
B.K.C.	4397			Contr. <u>McKnab &</u>
Ce. <u>Marm</u>	4812	4436		<u>Linsay Tools</u>
C. <u>Masch</u>	4871	4870		
M.	4988			
M. <u>S + Green</u>	4989	4986		Pool
K. <u>ST L</u>		5047		<u>Southside</u>
Mz. <u>atoka</u>		4806		
Mq.				
V.				
S.				
S.				
A.				
R.				
PE.				
G.				
T.D.	5225			

COMPLETE

OCT 23 57

Date Comm. 8/20/57

10" @ 852 w/600, drlg 2775 (Miss)

SEP 4 57 D4300 SEP 11 57 end 4970-5028full rec. 4990-97 dense linePrep core 5046 SEP 18 57 DST 402-42 90" 1090 GIP 585' HD 6@ CM EP 165-388 BH1025/20" DST 4562-462625" 10' md BH 1000/20" end 4970-502050' end 5046-97 51' show oil

DST 5125-75 50' NO sh. w s

5 1/2 5187 WOCT SEP 25 '57 CD

14/4988-95 22/5049-60

Bath 16/5108-16 C'Z"

no s mad 750 A & AZ

3.6 Boph no wtr no time

& B 2.5 Boph now

& C'Z 53 0 66 prep fr 2

all 3 joins OCT 2 '57 fr 20x20

& F10 55 Boph now 3 hrs

POP OCT 9 '57 OCT 16 '57 P 154 BO

now 22 hrs Jul 20 '57

p 168 BO NW 24 hrs

380 gr SZ

MISS 4988-95

5049-60

5108-16