

KANON

Kearny

Sec. 14 Twp. 26 R. 36W ✓

Well No. #1 Ramsey Farm

Fin-Ker

Hugoton (Mid-West, Cont.) Company

Pool


NORTH

_____ Ft. from N. Line

375' _____ Ft. from S. Line

375' _____ Ft. from E. Line

_____ Ft. from W. Line

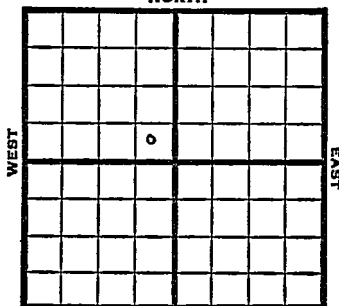

SE NW

SOUTH

1949 Elev 3019' REPORT

6/1	Surface Hole
6/7	"
6/15	10" @ 80' TD 2430' 7" @ 2429'
6/21	TD 2570'
6/28	"
7/6	"
7/12	"
7/20	"
7/27	"
8/3	"
8/10	TD 2640'
8/17	"
8/24	"
8/31	"
9/7	226' of 5" Perf liner @ 2643 TD Acid 2500
9/14	"
9/21	"
9/28	"
10/5	"
10/12	"
10/19	TD 2643' 7" @ 2429' 226' of 5" Perf Liner @ 2643' 25000 acid DA 1,861,000 Gas 405# R Pr.

COMPLETED

Map No. _____ Sec. 14 Twp. 26 R. 36W

Well No. 1 Ramsey

Fin-Ker Company

Mid-West Contractor

SE NW

FIRST REPORT
SECTION FLAT

_____ Ft. from N. Line

375 Ft. from S. Line

375 Ft. from E. Line

_____ Ft. from W. Line

		o	

Kearny County

Location _____

Rig up _____

Drilling and Remarks:

surface hole

RECORD

Cased _____ in., _____ ft.

Sand _____

Gas _____

Oil _____

Total Depth _____

PRODUCTION

1st 24 hrs. Nat. _____

1st 24 hrs. after shot _____

Gas _____ Cu. Ft.

Dry Hole _____

Abandoned _____

Date

JUN 1 1949

S. J. LEWIS Scout

Kansas

Hugoton Pool

Map No. _____ Sec. 14 Twp. 26 R. 36WWell No. 1 Ramsey

Fin-Ker _____ Company

COMPLETE

Contractor

SE NW

E1, 3019
SECTION FLAT

_____ Ft. from N. Line

375 Ft. from S. Line375 Ft. from E. Line

_____ Ft. from W. Line

Kearny County

Location _____

Rig up _____

Drilling and Remarks:

*7" C02428**226' x 5" Perf. lines**C02643**25000 acid**Dec 1, 86,000 per**405' RA*

RECORD

Cased _____ in., _____ ft.

Sand _____

Gas _____

Oil _____

Total Depth 2643

PRODUCTION

1st 24 hrs. Nat. _____

1st 24 hrs. after shot _____

Gas _____ Cu. Ft.

Dry Hole _____

Abandoned _____

Date

OCT 19 1949

19

S. J. LEWIS Scout