

KANSAS
2-46 PETROL

WEST

EAST

SOUTH

KANSAS Finney



Sec. 14 Twp. 26 R. 33W

Well No. #1 Kelly Farm

Stanolind Company
Hugoton


 Ft. from N. Line

50 Ft. from S. Line

 Ft. from E. Line

50 Ft. from W. Line

SW NE

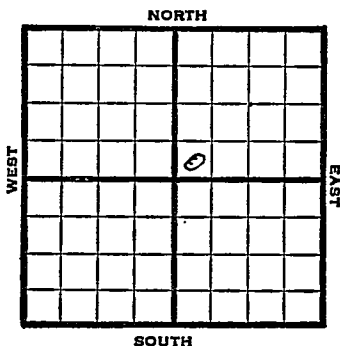

1947 Elev. 2895' REPORT

8/6 Drlg. 460'

8/13 10" @ 897'
Drlg. 2580'

8/20 TD 2784'
7" @ 2760'

8/27 24 shots. 269-2730 - 5000 acid
150 shots. 2635-60' - 3500 acid
84 shots. 2580-94' - 3500 acid
120 shots. 2600-20' - 5000 acid.

9/3 "

9/10 7" @ 2760'
Perf.
20,000 acid
3,322,000 gas.
420# R. Pr.
TD 2784'

COMPLETED

Map No. _____ Sec. 14 Twp. 26 R. 33W


Well No. 1 Kelly

Stanolind Company

FIRST REPORT Contractor

SW NE

SECTION PLAT

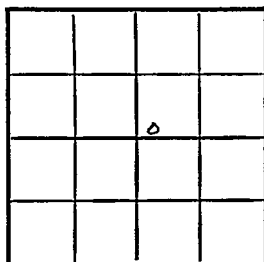

_____ Ft. from N. Line

50 Ft. from S. Line

_____ Ft. from E. Line

50 Ft. from W. Line

Finney County

Location _____

Rig up _____

Drilling and Remarks:

460'

RECORD

Cased _____ in., _____ ft.

Sand _____

Gas _____

Oil _____

Total Depth _____

PRODUCTION

1st 24 hrs. Nat. _____

1st 24 hrs. after shot _____

Gas _____ Cu. Ft.

Dry Hole _____

Abandoned _____

Date

AUG 6 1947 19 S. J. LEWIS Scout

Map No. 0 Sec. 14 Twp. 26 R. 33W

Well No. 1 Kelly


Stanolind Company

COMPLETE

Contractor

SW NE

E 1.2875
SECTION PLAT

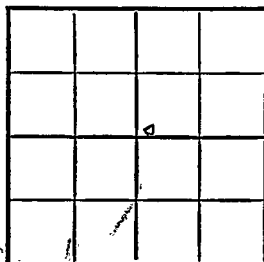

 Ft. from N. Line

50 Ft. from S. Line

 Ft. from E. Line

50 Ft. from W. Line

Finney County

Location

Rig up

Drilling and Remarks:

7" C 2760

P. J.

20000 acid

3,322,000 Gas

420 # R/P

RECORD

Cased in. ft.

Sand

Gas

Oil

Total Depth 2784

PRODUCTION

1st 24 hrs. Nat.

1st 24 hrs. after shot

Gas Cu. Ft.

Dry Hole

Abandoned

Date

SEP 10 1947

19

S. J. LEWIS

Scout