



Section 28 Township 26 Range 15 W
 Well No. # 1 Tatlock
 Company Anschutz Drlg. Co.

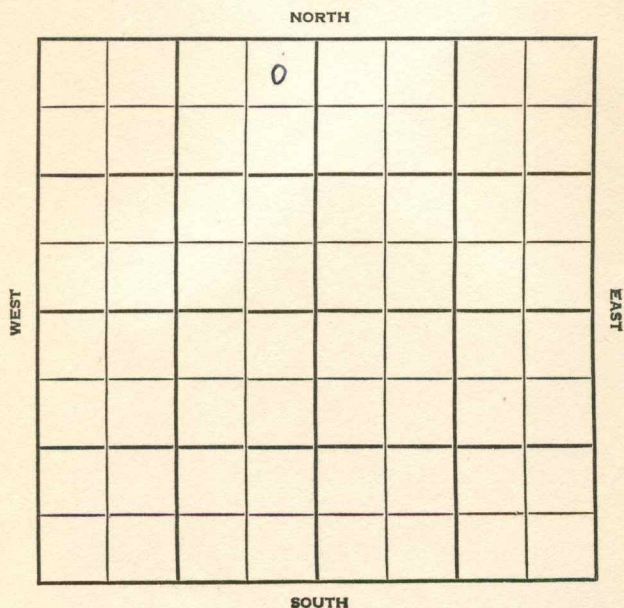

SEC. 28 TWP. 26 R. 15W
 WELL NO. 1 Tatlock FARM
 COMPANY
 CONTRACTOR Anschutz Drlg. Co.

Anschutz Tools
 Wildcat

330 Ft. from N. Line
 Ft. from S. Line
 330 Ft. from E. Line
 Ft. from W. Line

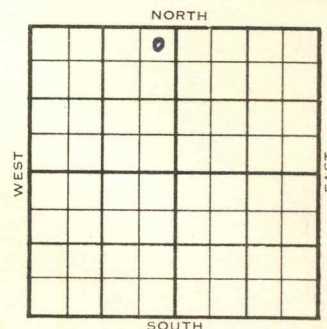

NE NE NW
 Lion DHM - Tatlock FO

	ELEVATION	REPORT
1954	2050'	
9/29	Spud 9-25-54 8" @ 325' w/250 Drlg. 1460'	
11/23	Spud 9-25-54 - Oil Well TD 4701' 8" @ 325' Heeb. 3727', Br. lime 3884', Lans 3903' DST 3906-42', opn 45", gas in 4", rec. 570' oil, 1260# Miss 4322' DST 4324-33', opn 1 hr., rec. 10' mud 425# Viola 4416', Simp. 4583', Simp sd 4617', Arb. 4657' DST 4660-80', opn 1 hr., rec. 130' wt 160# TD 4700' 5" @ 4230' chl: Lans 3905', Kh. 4373', Viola 4416', Simp. sh. 4592', Simp. sd. 4618', Arb. 4675' TD 4701' CO 24/3925-29, F/2½ boph 3 hrs. Dec. to .83 bo P/83.5 bo 3½ hrs. Comp. 455 bopd	

County Pratt State Kansas
 Sec. 28 (Blk. Twp.) 26 (Sur. Rge.) 15W Map No.
 Operator Anschutz Drlg.
 Well No. 1 Farm Tatlock
 Elev. 2050 Location NE NE NW

330 Ft. From N Line NW
330 Ft. From E Line Quarter
 1st. Report
 Completion NOV 23 1954
 Remarks Wildcat
Anschutz - Contr.
 Spudding Date 9-25-54

Drlg. Data Oil well TD 4701
8" @ 325 Heeb. 3727 Br. lime 3884
Lans. 3903 DST 3906-42 open 45 min.
gas in 4 min. Rec. 570' oil 1260#
Miss. 4322 DST 4324-33 open 1 hr.
Rec. 10' mud 425# Viola 4416
Simp. 4583 Simp. sd. 4617 Arb. 4657
DST 4660-80 open 1 hr. Rec. 130' wtr.
160# TD 4700 5" @ 4230
SCHLUMBERGER TOPS:
Lans. 3905 Kh. 4373 Viola 4416
Simp. sh. 4592 Simp. sd. 4618 Arb. 4675
TD 4701 CO 24/ 3925-29 F/ 2½ boph
3 hr. dec. to .83 bo P/ 83.5 bo 3½ hr.
Comp. 455 bopd

FABEN GILSTRAP

County Pratt State Kansas
 Sec. 28 (Blk. Twp.) 26 (Sur. Rge.) 15W Map No.
 Operator Anschutz Drlg. Co.
 Well No. 1 Farm Tatlock
 Elev. Location NE NE NW

330 Ft. From N Line NW
330 Ft. From E Line Quarter
 1st. Report SEP 29 1954
 Completion
 Remarks Lion DHM - Tatlock FO
Steve Powell - Geol.
Anschutz Tools
 Spudding Date 9/25-54

Drlg. Data Wildcat
8" @ 325 w/250 Drlg. 1460

FABEN GILSTRAP