


DX 78-1 Pratt

Section 28 Township 26 Range 15W

Well No. 2 Tatlock

Company Fred B. Anschutz

KANSAS

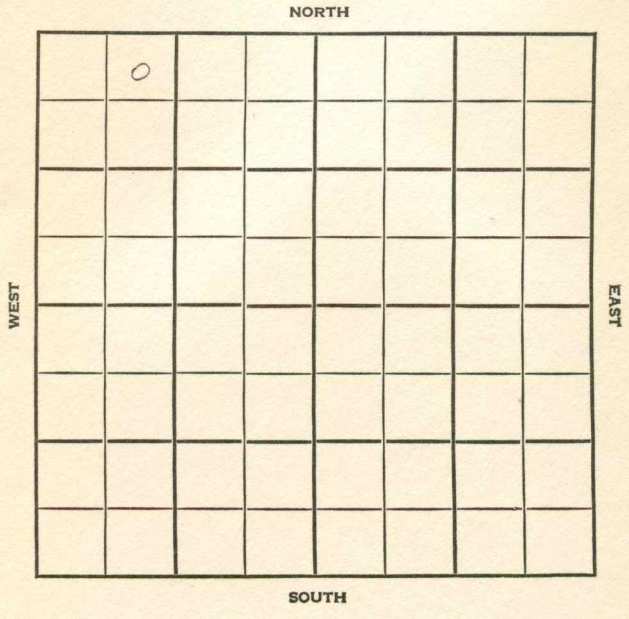

SEC. TWP. R. **Pratt KANSAS**

WELL NO. 28 26 15 W

COMPANY # 2 Tatlock FARM

CONTRACTOR Fred B. Anschutz

Co. tools
Tatlock Pool


330 Ft. from N. Line

_____ Ft. from S. Line

_____ Ft. from E. Line

990 Ft. from W. Line

NE NW NW

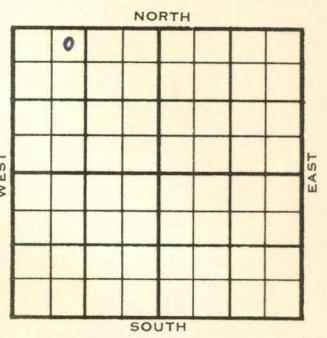

ELEVATION REPORT

1955

4/27

Spud 4-23-55
8" @ 357 **Anhy 995'**
Drlg. 1975'

County Pratt State Kansas

Sec. 28 (Bk. 26 (Sur. 15W Map No. (Twp.) (Rge.)

Operator Fred B. Anschutz

Well No. 2 Farm Tatlock

Elev. _____ Location NE NW NW

0				

330 Ft. From N Line NW

990 Ft. From W Line Quarter

1st. Report APR 27 1955

Completion _____

Remarks _____

Co. tools

Spudding Date 4-23-55

Drig. Data Tatlock Pool

8" @ 357 Anhy 995 drlg. 1975

K-26

FABEN GILSTRAP