


Pratt

KANSAS

SECTION 30 TOWNSHIP 26S RANGE 15W

WELL NO. #1 Tatlock "B"

COMPANY Mull Drlg.

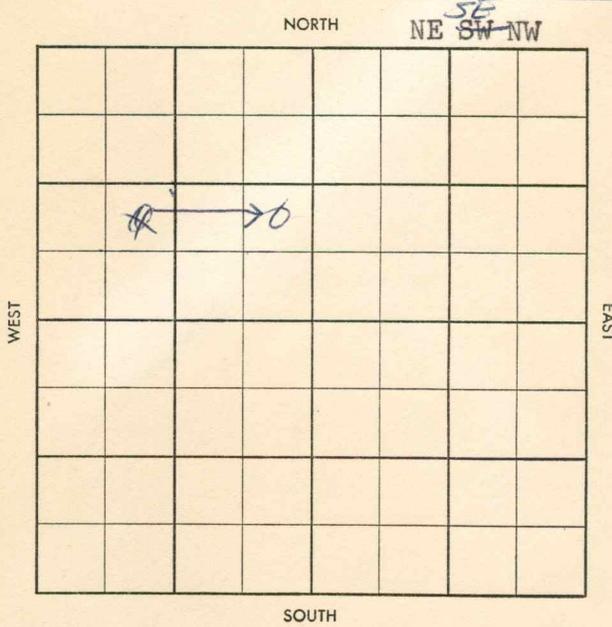

Twp. ~~Pool~~ ~~Co.~~ ~~Facet~~ **76**

S-513-B

County Pratt Elev. 2058
 Sec. 30 Twp. 26 Rge. 15W
 Company Mull Drlg.
 Farm Name Tatlock "B" No. 1

TOPS	DEPTH	LOG	DATUM	Loc. in Sec.
Anh.				<u>NE SW NW</u>
Tp.				
H.				
Tr.				
Dg.				
B.L.				
L.				
K.C.				Geol.
B.K.C.				Contr.
Ce.				<u>Co. tools</u>
C.				Pool
M.				<u>Tatlock</u>
K.				
Mz.				
Mq.				
V.				
S.				
S.				
A.				
R.				
Pf.				
G.				
T.D.				

FIRST REPORT
MAY 14 58

Date Comm. 5-8-58
8" @ 777/525 drlg. 2520

Twp. ~~Pool~~

Co. ~~Facet~~

CORRECTION

S-513-B

County Pratt Elev. 2058
 Sec. 30 Twp. 26 Rge. 15W
 Company Mull Drlg.
 Farm Name Tatlock "B" No. 1

TOPS	DEPTH	LOG	DATUM	Loc. in Sec.
Anh.				<u>NE SW NW</u>
Tp.	<u>3748</u>			<u>SE</u>
H.				
Tr.				
Dg.	<u>3786</u>			
B.L.	<u>3802</u>			
L.	<u>3918</u>			
K.C.				Geol.
B.K.C.				Contr.
Ce.				<u>Co. tools</u>
C.				Pool
M.				<u>Tatlock</u>
K.				
Mz.				
Mq.	<u>4411</u>			
V.	<u>4582</u>			
S.				
S.	<u>4665</u>			
A.				
R.				
Pf.				
G.				
T.D.	<u>4686</u>			

ABANDONED
MAY 28 58

Date Comm. 5-8-58
8" @ 777/525 drlg. 2520 MAY 21 58 DST
3990 - 4005 120" glio' TSM
rec 150' oil 1170 SW SP 280
-990 BHP 1380 - 1270/30" DST 4062
-78 120" 336' gip 40' gem
BHP 1420 - 960/30" 4197
ran log
DOA