

Pratt


KANSAS

SECTION 31 TOWNSHIP 26S RANGE 15W

WELL NO. #1 Tatlock "C"

COMPANY Mull Drlg.

NORTH SE NE SW

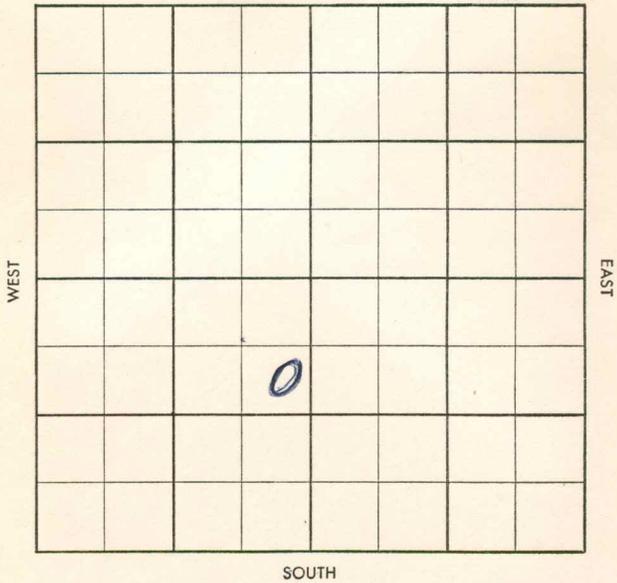

SOUTH

~~Top~~ ~~Pool~~
~~Co.~~ ~~Foot~~

S-513-B

County Pratt Elev. _____
 Sec. 31 Twp. 26 Rge. 15W
 Company Mull Drlg.
 Farm Name Tatlock "C" No. 1

TOPS	DEPTH	LOG	DATUM
Anh.			
Tp.			
H.			
Tr.			
Dg.			
B.L.			
L.			
K.C.			
B.K.C.			
Ce.			
C.			
M.			
M.			
K.			
Mz.			
Mq.			
V.			
S.			
S.			
A.			
R.			
Pf.			
G.			
T.D.			

Loc. in Sec. SE NE SW
 Geol. _____
 Contr. _____
 Pool Co. tools
SW Tatlock



Date Comm. 5-24-58
8" @ 630/425 drlg. 1380

Co.
L.S.
No.
Sec.
T.
K.

Twp. ~~Pool~~
Co. ~~Facet~~

5-513-B

County Pratt Elev. 2064 OF 2067 RB
 Sec. 31 Twp. 26 Rge. 15W
 Company Mull Drlg.
 Farm Name Tatlock "C" No. 1

TOPS	DEPTH	LOG	DATUM	Loc. in Sec.
Anh.				SW NE SW
Tp.	3799			
H.				
Tr.	3843			
Dg.	3957			
B.L.	3968			
L.				
K.C.	4310			
B.K.C.				Co. tools
Ce.				
C.	4429			
M.	DST			Pool
M.	SD 4476			SW Tatlock
K.				
Mz.				
Mq.				
V.				
S.				
S.				
A.				
R.				
Pf.				
G.				
T.D.	458			

ABANDONED
 JUN 11 '58

Date Comm. 5-24-58
8" @ 630/425 drlg. 1380 JUN 3 '58 ϕ 3595
JUN 11 '58 Tops DST 4421 - 49 2hrs
 rec 60' gem FPO - 0 BHP 1240 -
 440 130" DST 4449 - 93 2hrs
 60' 50 b gem FPO - 0 BHP
 620 - 0/30"
 D&A