


Section 13 Township 26 Range 15 W

Well No. # 1 Lutes

Company Deep Rock

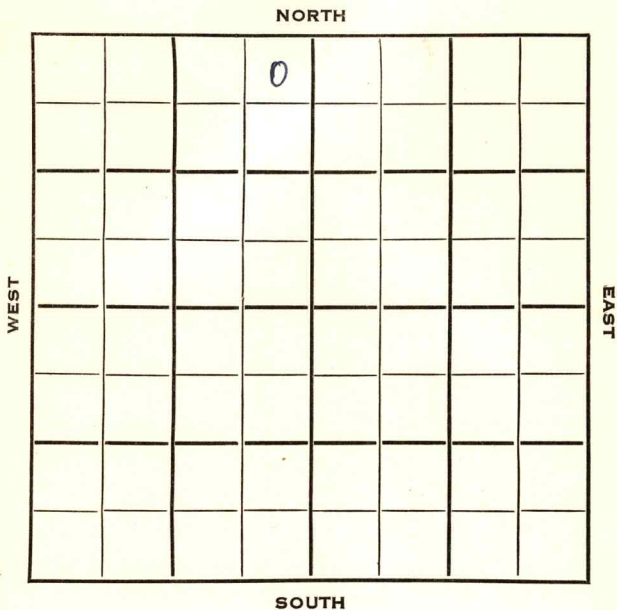

Pratt

KANSAS

SEC.	TWP.	R.
13	26	15 W

WELL NO.

1 Lutes

FARM

COMPANY

Deep Rock

CONTRACTOR

Rine Drlg.

Gereke Pool

330 Ft. from N. Line

Ft. from S. Line

330 Ft. from E. Line

Ft. from W. Line

NORTH

			0			

WEST

EAST

SOUTH

NE NE NW

ELEVATION

REPORT

1954

2027'

4/14

Spud 4-8-54

10" @ 429

Drlg. 2915'

4/28

Spud 4-8-54 D & A TD 4640'

10" @ 429 Heeb 3680 Br lime 3837

Lans. 3865 ~~Heeb 3680~~ Viola 4381

DST 4434-64 open 3/4 hr, rec 10' mud

O# Simp. sh. 4537' Simp. sd. 4553'

Arb. 4604' TD 4640' D & A

ABANDONED

County **Pratt** State **Kansas**Sec. **13** (Blk.) **26** (Sur.) **15W** Map No.Operator **Deep Rock**Well No. **1** Farm **Lutes**Elev. Location **NE NE NW**

FIRST REPORT

330 Ft. From **N** Line **NW****330** Ft. From **E** Line Quarter1st. Report **APR 14 1954**

Completion

Remarks

Rine Drlg. - Contr.Spudding Date **4-8-54**Drlg. Data **Gereke Pool****10" @ 429 drlg. 2915**

J. G. McGEHEE

County Pratt State KansasSec. 13 (Blk. 26 (Sur. 15W Map No.)
(Twp.) (Rge.)Operator Deep RockWell No. 1 Farm LutesElev. 2027 Location NE NE NW330 Ft. From N Line NW330 Ft. From E Line Quarter1st. Report Completion APR 28 1954Remarks Gereke PoolRine Drlg. - Contr.Spudding Date 4-8-54Drlg. Data D & A TD 464010" @ 429 Heeb. 3680 Br. lime 3837Lans. 3865 Viola 4381 DST 4434-64open 3/4 hr. Rec. 10' mud 0#Simp. sh. 4537 Simp. sd. 4553 Arb. 4604TD 4640D & A