


Section 21 Township 26 Range 15W


Well No. #1 Curtis

Company J. H. Tatlock

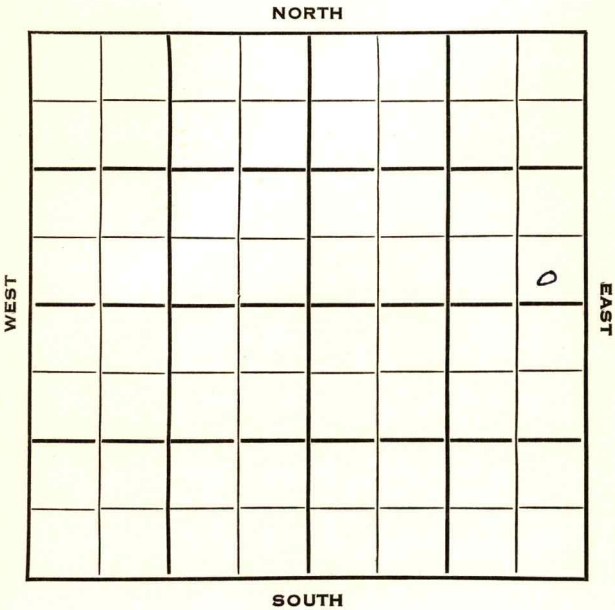

HOT FILE

Pratt

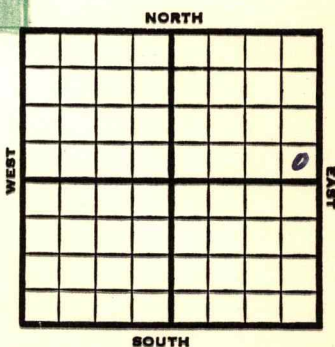KANSAS ✓Sec. 21 Twp. 26 R. 15 WWell No. # 1 Curtis FarmJ. H. Tatlock CompanyRine Drlg. ContractorWildcat Ft. from N. Line330 Ft. from S. Line330 Ft. from E. Line Ft. from W. Line

SE SE NE

Lion - DHM

MCPC has SE of 17

1953 **Elev. 2050'** REPORT

- 3/11 Spud 3-5-53
8" @ 845' WOC
- 3/19 **Anhy 835'**
Drlg. 3641' (Ltr)
- 3/26 **Heeb 3763' Br lime 3927'**
Lans. 3938' Miss 4404'
DST 4405-15, open 1 hr. rec 15' mud
& VSSO, Off **Kh. 4436' Viola 4505'**
BST in Lans. 3945-68, open 1 hr, rec
3330' gas, 1620' gassy oil. 600#
DST 3980-4000, open 1 hr. rec 1390'
SW. 1315# **Simp. 4629' Arb. 4692'**
TD 4736' (Ltr)
- 4/2 Set 5½" @ 4457'
CO & perf 42 holes 3946-56
Filled up w/1500' oil (tel)
- 4/10 S/2 BWPH & SSO S/2 BFPH 10% oil
1000 A S/4 to 5 BWPH (Ltr)
- 4/16 66/4406-17, 2 GM & wtr. A-frac. "
- 4/22 Spud 3-5-53
D & A
TD 4736'
8" @ 845'
Anhy 835, Heeb 3763, Br. Lime 3927,

OVER

1953

Information brought forward

4/22

Lans 3938, Miss 4404,

DST 4405-15 open 1 hr. rec 15' mud &

VSSO 0# Kh 4436, Viola 4505,

DST 3945-68 opn 1 hr. 3330' gas

1620' gassy oil 600#

DST 3980-4000 open 1 hr, rec 1390'

SW 1315# Simp 4629, Arb 4692

TD 4736

5" @ 4457

SCHLUMBERGER TOPS:

Heeb 3764, Br. Lime 3921, Lans 3940,

B KC 4276, Miss 4404, Kh 4432, Viola

4503, Simps 4632, Arb 4695,

42/ 3946-56 FU 1500' oil S/ mud &

oil S/ 2 bwph & SSO S/ 2 bfph

10% oil 1000 A S/ 4 to 5 bwph

66/ 4406-17 2 gm & wtr. A-frac

B/ 2½ gm & wtr.

D & A

ABANDONED

County Pratt State KansasSec. 21 (Blk.) 26 (Sur.) 15W Map No.Operator J. H. TatlockWell No. 1 Farm CurtisElev. Location SE SE NE

330 Ft. From S Line NE330 Ft. From E Line Quarter1st. Report MAR 11 1953Completion Lion - DHMRemarks MCPC has SE of 17Rine Drlg. - Contr.Spudding Date 3-5-53Drlg. Data Wildcat8" @ 845 WOC

J. G. McGEHEE

County Pratt State Kansas
 Sec. 21 (Blk.) 26 (Sur.) 15W Map No.

Operator J. H. Tatlock

Well No. 1 Farm Curtis

Elev. 2050 Location SE SE NE



330 Ft. From S Line NE

330 Ft. From E Line Quarter

1st. Report

Completion APR 22 1953

Remarks Wildcat

Rine Drlg. - Contr.

Spudding Date 3-5-53

Drlg. Data D & A TD 4736

8" @ 845 Anhy 835 Heeb. 3763

Br. lime 3927 Lans. 3938 Miss. 4404

DST 4405-15 open 1 hr. Rec. 15' mud &

VSSO 0# Kh. 4436 Viola 4505

DST 3945-68 open 1 hr. 3330' gas

1620' gassy oil 600# DST 3980-4000

open 1 hr. Rec. 1390' sw 1315#

Simp. 4629 Arb. 4692 TD 4736

5" @ 4457 SCHLUMBERGER TOPS

Heeb. 3764 Br. lime 3921 Lans. 3940

B KC 4276 Miss. 4404 Kh. 4432

Viola 4503 Simp. 4632 Arb. 4695

42/ 3946-56 FU 1500' oil S/ mud & oil


S/ 2 bwph & SSO S/ 2 bfph 10% oil

J. G. McGEHEE

Drlg. Data

1000 A S/ 4 to 5 bwph 66/ 4406-17

2 gm & wtr. A frac B/ $2\frac{1}{2}$ gm & wtr.

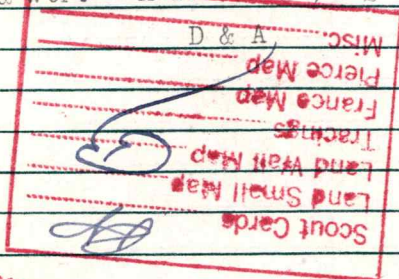

APR 28 1965