


DX 78-1

Hamilton KANSAS

Section 15 Township 26 Range 39W

Well No. 1 Stucky Gas Unit "B"

Company Stanolind

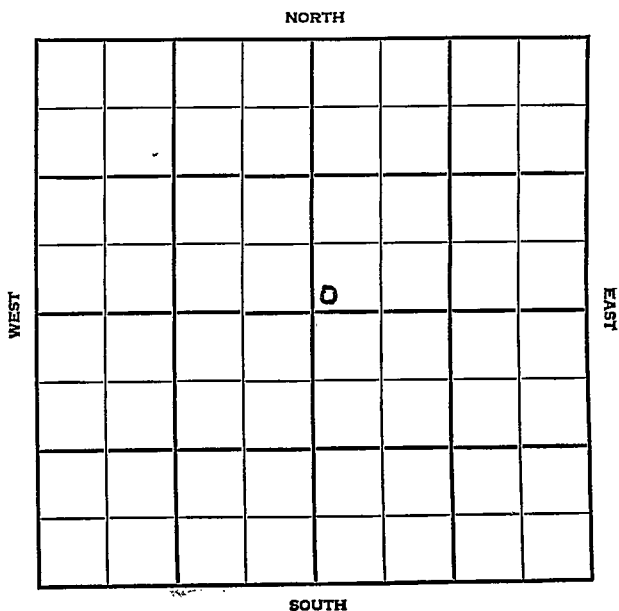

Hamilton

KANSAS

SEC.	TWP.	R.
15	26	39 W

WELL NO.

1 Stucky Gas Unit "B"

FARM

COMPANY

Stanolind

CONTRACTOR

Hugoton Pool

Ft. from N. Line

150


Ft. from S. Line

Ft. from E. Line

150

Ft. from W. Line

SW SW NE

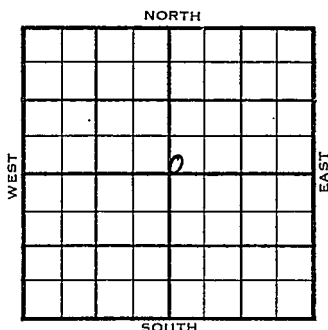

	ELEVATION	REPORT
1954	3345'	

4/27

Spud 4-21-54 8" @ 664
 Her. 2496 Win 2548 Tow. 2615
 Ft. Riley 2666' TD 2684'
 5" @ 2666'

5/19

Spud 4-21-54
 Gas Well
 TD 2684'
 8" @ 664'
 Her. 2496', Win 2548', Tow. 2615',
 Ft. Riley 2666'
 TD 2684'
 5" @ 2666'
 CO to 2684 frac 638,000 gas
 36/ 2496-2502 24/ 2512-16 24/ 2520-
 24 18/ 2526-29 18/ 2531-34 84/
 2548-72 24/ 2576-80 18/ 2583-86
 54/ 2599-2608 18/ 2610-13 24/ 2620-24
 60/ 2626-36 6,670,000 gas 10 gfph
 dol-frac.
 Comp 9,978,000 gas 372#

COMPLETED

County **Hamilton** State **Kansas**

Sec. 15 (Blk. Twp.) 26 (Sur. Rge.) 39W Map No.

Operator **Stanolind**

Well No. **1**, Farm **Stucky Gas Unit "B"**

Elev. **3345** Location **SW SW NE**

0

FIRST REPORT

150 Ft. From **S** Line **NE**

150 Ft. From W Line Quarter

1st. Report **APR 27 1954**

Completion

Remarks

Spudding Date **4-21-54**


Drig. Data Hugoton Pool

8" @ 664 Her. 2496 Win. 2548

Tow. 2615 Ft. Riley 2666 TD 2684

5" @ 2666

County Hamilton State Kansas
 Sec. 15 (Blk. Twp.) 26 (Sur. Rge.) 39W Map No. _____
 Operator Stanolind
 Well No. 1 Farm Stucky Gas Unit "B"
 Elev. 3345 Location SW SW NE

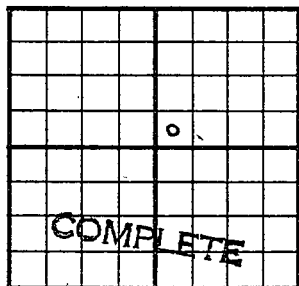

150 Ft. From S Line NE
150 Ft. From W Line Quarter

Ist. Report _____

Completion MAY 18 1954

Remarks Hugoton Pool

Spudding Date 4-21-54

Drlg. Data Gas well TD 2684
8" @ 664 Her. 2496 Win. 2548
Tow. 2615 Ft. Riley 2666 TD 2684
5" @ 2666 CO to 2684 frac 638,000 gas
36/ 2496-2502 24/ 2512-16 24/ 2520-24
18/ 2526-29 18/ 2531-34 84/ 2548-72
24/ 2576-80 18/ 2583-86 54/ 2599-2608
18/ 2610-13 24/ 2620-24 60/ 2626-36
6,670,000 gas 10 gfph dol-frac
Comp. 9,978,000 gas 372#

J. G. McGEHEE