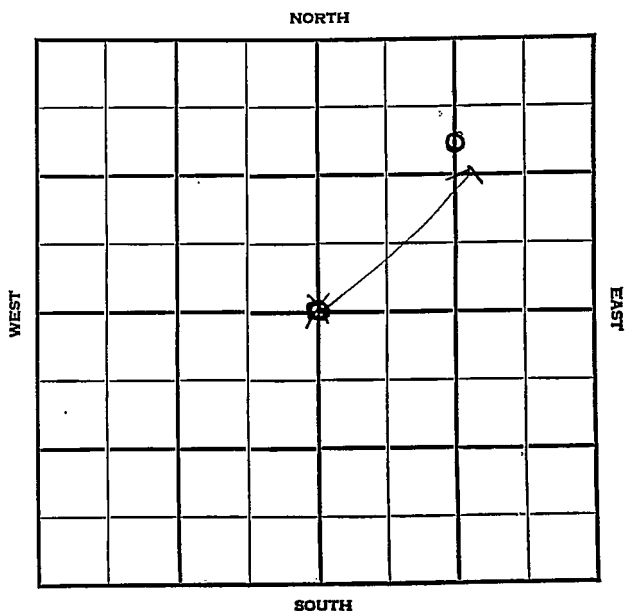


Section 15 Township 26 Range 35WWell No. #11 Bldg. & LoanCompany Helmerich & Payne

Sec. 15 Twp. 26 R. 35WWell No. #11 Bldg. & Loan FarmHelmerich & Payne CompanyHugoton990
2640 Ft. from N. Line


Ft. from S. Line

1320
2640 Ft. from E. Line

Ft. from W. Line

CSL N $\frac{1}{2}$ NE

C. Sec.

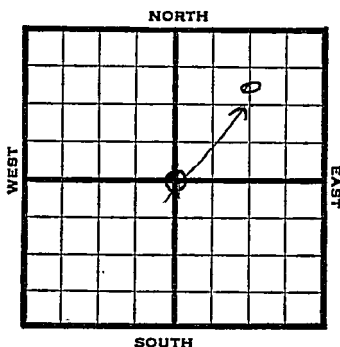

1948 Eli 3003' REPORT

1/28 RUR

2/4 10" @ 794'
Drlg. 2100'2/11 TD 2490'
7" @ 2487'2/18 Drlg 2610'
3000 acid2/25 TD 2720'
10,000 acid.

3/3 "

3/10 "

3/17 "

3/24 238' of 5 Perf liner @ 2720'

3/31 "

4/7 "

4/14 "

4/21 "

4/28 "

5/5 "

5/12 "

5/19 "

5/26 "

6/1 "

OVER

1948

6/9 238' of 5 Perf liner @ 2720'
6/16 "
6/23 " "
6/29 " "
7/8 " "
7/14 " "
8/21 TD 2720'
7" @ 2487'
238' of 5" Perf Liner @ 2720'
24000 acid
11 M Gas
426# R Pr.
Comp.
COMPLETED

*Check Ref to Survey
7/23/48 - for location
in country*

Map No. _____ Sec. 15 Twp. 26 R. 35W

Well No. 11 Bldg. & Loan

Helmerich & Payne Company

FIRST REPORT Contractor

C Sec. _____


SECTION PLAT

2640 Ft. from N. Line

_____ Ft. from S. Line

2640 Ft. from E. Line

_____ Ft. from W. Line

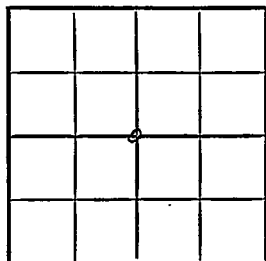

Kearny County

Location _____

Rig up _____

Drilling and Remarks:

R U R

RECORD

Cased _____ in., _____ ft.

Sand _____

Gas _____

Oil _____

Total Depth _____

PRODUCTION

1st 24 hrs. Nat. _____

1st 24 hrs. after shot _____

Gas _____ Cu. Ft.

Dry Hole _____

Abandoned _____

Date

JAN 28 1948

19

S. J. LEWIS

Scout

Misc Small Maps
Cards *Ruth*
Tracing *L*
France Map *L*
Scarborough Map *L*
Pierce Map *L*
Geological Dept. _____
Pierce Plat Book _____

No map
Map No. _____ Sec. 15 Twp. 26 R. 35W

Well No. 11 Bldg. & Loan

Helmerich & Payne Company

CORRECTION Contractor

C S L N $\frac{1}{2}$ NE

990 Ft. from N. Line

_____ Ft. from S. Line

1320 Ft. from E. Line

_____ Ft. from W. Line

Kearny County

SECTION PLAT

			o

Location _____

Rig up _____

Drilling and Remarks:

Reported

C Sec.

RECORD

Cased _____ in., _____ ft.

Sand _____

Gas _____

Oil _____

Total Depth _____

PRODUCTION

1st 24 hrs. Nat. _____

1st 24 hrs. after shot _____

Gas _____ Cu. Ft.

Dry Hole _____

Abandoned _____

Date

FEB 11 1948 19 S. J. LEWIS Scout


Misc. Small Maps	
Cards	<i>cut</i>
Tracing	<i>cut</i>
France Map	<i>cut</i>
Scarborough Map	<i>cut</i>
Pierce Map	<i>cut</i>
Geological Dept.	
Pierce Plot Book	

Map No. _____ Sec. 15 Twp. 26 R. 35WWell No. 11 Bldg. & Loan_____ Helmerich & Payne Company**COMPLETE**

Contractor

C S L N $\frac{1}{2}$ NEE 13003

SECTION PLAT

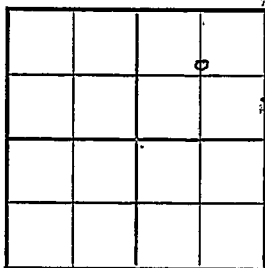990 Ft. from N. Line Ft. from S. Line1320 Ft. from E. Line Ft. from W. LineKearney County

Location _____

Rig up _____

Drilling and Remarks:

7" @ 2487238' of 8" Perf liner@ 272024000 and 1/2110M Gas426 #2 R

RECORD

Cased _____ in., _____ ft.

Sand _____

Gas _____

Oil _____

Total Depth 2720

PRODUCTION

1st 24 hrs. Nat. _____

1st 24 hrs. after shot _____

Gas _____ Cu. Ft.

Dry Hole _____


Abandoned _____

Date

JUL 21 194819S. J. LEWIS Scout

Sandy -

Your first report
covered this well
in Keary Co.

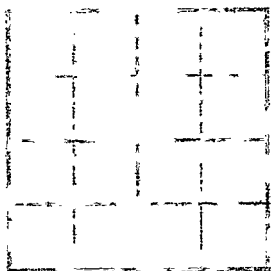

Imperial

1881 2nd 1st

1881 1st 1st

1881 1st 1st

Misc. Small Maps	
Cards	<i>[Signature]</i>
Tracing	<i>[Signature]</i>
France Map	<i>[Signature]</i>
Scarborough Map	<i>[Signature]</i>
Pierce Map	<i>[Signature]</i>
Geological Dept.	
Pierce Plat Book	