

Edwards

KANSAS


Edwards

KANSAS

SECTION 12 TOWNSHIP 26 RANGE 16 W

WELL NO. #1 Johnson *Salsen*

COMPANY F. Kirk Johnson

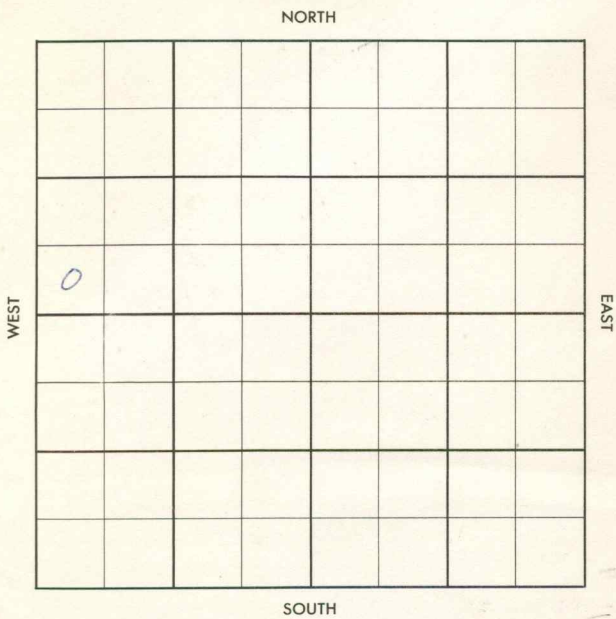

SEC. 12 TWP. 26 R. 16 W

WELL NO. #1 Johnson *Salsen* FARM

COMPANY F. Kirk Johnson

CONTRACTOR Garvey


~~Wildcat~~ *Salsen* Ft. from N. Line

Ft. from S. Line

Ft. from E. Line

Ft. from W. Line

SW SW NW

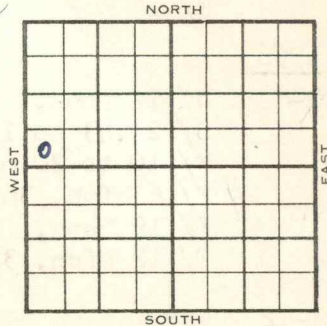

SDX - 1/2 Mile Magnolia-AC

| ELEVATION | REPORT |
|----------------|--|
| 1955 | |
| 11/16 | Location |
| 12-1 | Spud 11-22-55 8 5/8" @ 275/300 Drlg. 3040 |
| 12-8 | DST 3933-50, op 1 hr. 800' GIP, rec. 110' so&gcm, 590/30" DST 4025-35, op 1 hr. rec. 610' sw, 145/30" DST 4075-4103, op 1 hr. rec. 80' msw, 1475/30" Heeb. 3763, Doug. 3807 Br. lime 3918 Lans. 3932' |
| 12-15 | DST 4388-4420, op 1 hr. gas to surface in 8 min., rec. 95' vom, 60' om, 60' smco, 60' clean oil, 1475/20" DST 4420-40, op 1 hr. rec. 25' mud, 850/20" DST 4443-60, op 1 hr. rec. 60' socm, 10/30" DST 4460-70, op 1 hr. rec. 30' mud, 940/30" DST 4530-4610, op 1 hr. rec. 460' sw, 1440/20" Drlg. 4707 |
| 12-22 DX-78 | 5 1/2" @ 4550, CO, 88/ 4398-4420, 750 A S/ 1/2 boph |

12-29 S/ 29.43 BO 13 hrs., frac
S/ 10 BOPH 1 hr.
F/ 10 to 20 BOPH, 10% wtr.
F/ 6 bfph, 36% wtr. 11 hrs.
F/ 15 BOPH

1956

1-6 S/ $1\frac{1}{2}$ boph,
S/ 29.43 bo 13 hrs.,
F/ 10 to 20 boph, 10 % wtr.,
F/ 6 bfph, 36% wtr., 11 hrs.,
F/ 15 boph,
F/ 12 bfph, 34% wtr.

1-12 Waiting on potenital

1-19 P/ 37 bopd, 2% wtr.

1-26 P/ 40 bo, 40% wtr.

2-2 No report

2-8 P/ 35 bopd 15% wtr.

2-16 P/20 bopd, 40% wtr.

Am. ...

CORRECTION

FORM 513 REV. SUNRAY

County Edwards Elev. 2063
 Sec. 12 Twp. 26 Rge. 16W
 Company F. Kirk Johnson
 Farm Name Johnson Salsen No. 1

| | TOPS | DEPTH | LOG | DATUM | Loc. in Sec. |
|------|------|-------|------|-------|--------------|
| Top | | | | | SW SW NW |
| H. | | 3763 | 3765 | 1702 | |
| Tr. | | | | | |
| Dg. | | 3807 | 3808 | 1742 | |
| Bl. | | 3912 | 3920 | 1857 | |
| L. | | 3932 | 3934 | -1898 | |
| R.C. | | | | | |
| B.C. | | 4259 | | 2196 | |
| Ce. | | | | | |
| C. | | | | | |
| M. | chat | 4389 | 4391 | 2326 | Garvey |
| N. | | | | | |
| K. | 4444 | | 4438 | 2375 | Salsen |
| B.C. | 4473 | | | 2410 | Wildcat |
| Me. | | | | | |
| V. | | 4523 | 4523 | 2460 | |
| S. | | 4653 | 4653 | 2590 | |
| A. | | 4737 | 4737 | 2674 | |
| R. | | | | | |
| Pe. | | | | | |
| G. | | | | | |
| TD | | 4765 | | | |

COMPLETE
 1/4 mile
 FEB 22 1956

Date Comm. Magnolia - AC
 Location NOV 23 '55 NOV 30 '55 11-22-55
 25' 275/300 3040 DEC 7 '55
 DST 3933-50 1 hr rel 800' GIP
 110' 50' 80' FP 28-42 BHP
 590/30" DST 4025-35 1 hr
 610' SW FP 20-250 BHP
 1450/30" DST 4075-4103 1 hr
rel 80' MSW BHP 1475/30"
 DEC 4 '55 X DST 4388-4420 1 hr

FORM 513 REV. SUNRAY

County Edwards Elev. 16W
 Sec. 12 Twp. 26 Rge. 16W
 Company F. Kirk Johnson
 Farm Name Johnson No. 1

| | TOPS | DEPTH | LOG | DATUM | Loc. in Sec. |
|--------|------|-------|-----|-------|--------------|
| Top | | | | | SW SW NW |
| H. | | | | | |
| Tr. | | | | | |
| Dg. | | | | | |
| Bl. | | | | | |
| L. | | | | | |
| K.C. | | | | | |
| B.K.C. | | | | | |
| Ce. | | | | | |
| C. | | | | | |
| M. | | | | | |
| K. | | | | | |
| Mz. | | | | | |
| Me. | | | | | |
| V. | | | | | |
| S. | | | | | |
| A. | | | | | |
| R. | | | | | |
| Pe. | | | | | |
| G. | | | | | |
| TD | | | | | |

FIRST REPORT
 1/4 mile

Date Comm. Magnolia - AC
 Location

NOV 16 1955

25

35 Bo + 15% wtr 24 hrs
FEB 15 '56 P. app 20 Bopd + 40
% wtr. FEB 22 '56 P. 35 Bo
36% wtr 24 hrs. grav
35.5°

B. to S. 8" nec 95' V Oily Mud
+ 60' oily Mud + 60' SMCO + 60'
clean oil FP 32-98 BHP
1475/20" DST 4420-40 1hr
nec 25' Md FP 50-60 BHP
850/20" ϕ 4440 DST 4443-60
1hr nec 60' SOCM FP 20-60
BHP 10/30 DST 4460-70 4hr
1hr nec 30' Md FP 25-55
BHP 940/30" DST 4530-4610
1hr nec 460' SW FP 90-320
BHP 1440/20" ϕ 4633 ϕ 4707
DEC 21 '55 5 1/2 4550 ca 88/4398
- 4420 Bp & Ld. 1/2 Bopd
(8506) tstg. DEC 20 '55 1 1/2 Bopd
\$ 29.43 Bo 13 hrs Flwd
\$ 10 Bopd 1hr Flwd
10 To 20 Bopd 10% wtr
2" Tdg. TP 20# Flwd
6 BFph 36% wtr 11 hrs
20/64" ch Flw 15 Bopd
Tr wtr SIP 2000# JAN 5 '56
Flw 12 BFph 34% wtr
24/64" ch TP 280#
To Run GOR Test. JAN 11 '56
Wa Pat. JAN 18 '56 P. 37 Bopd
+ 2% wtr JAN 25 '56 P. 40
Bo + 40% wtr.
grav 35.5° FEB 1 '56 FEB 8 '56 P.

COLLECTION

