



Section 21 Township 26S Range 16W
 Well No. #1 Schultz
 Company N. C. R. A.

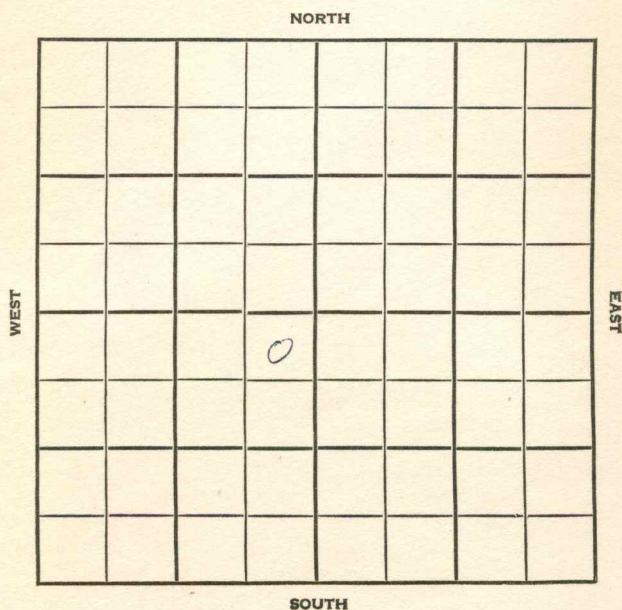

SEC. 21 TWP. 26S R. 16W
 WELL NO. 1 Schultz
 COMPANY N.C.R.A.
 CONTRACTOR Armer
Trousadle

_____ FT. FROM N. LINE
 _____ FT. FROM S. LINE
 _____ FT. FROM E. LINE
 _____ FT. FROM W. LINE

NE NE SW

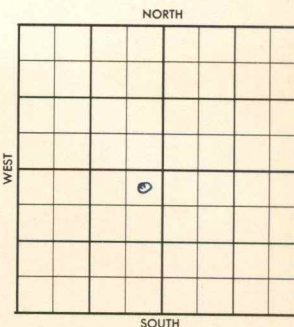

ELEVATION		REPORT
1956	2096'	
6-20	Location	
8-8	Comm. 7-16-56 8 5/8" @ 378 w/235 D & A H. 3841'; Tr. 3861'; BL. 3995'; # L. 4005'; BKC 4353'; M. 4539'; K. 4588'; V. 4651'; TD 4670'	
ABANDONED.		

County Edwards Elev. 2096
 Sec. 21 Twp. 26S Rgs. 16W
 Company N.C.R.A.
 FarmName Schultz No. 1

TOPS	DEPTH	LOG	DATUM	Loc. in Sec.
Anh.				NE NE SW
Tr.				
H.	3841			
Tr.	3867			
Dg.				
Bl.	3995			
L.	4005			
K.C.				Geol.
B.K.C.	4353			Contr.
Ce.				Armer
C.				
M.	4539			Pool
M.				
K.	4588			Trousadle
Mz.				
Me.				
V.	4651			
S.				
S.				
A.				
R.				
PE.				
G.				
TD.	4670			

Date Comm. Loc. JUN 27 '56 JUL 3 '56

JUL 18 '56 JUL 25 '56 7-16-56 85/F 378

1235 ID 2270 AUG 1 '56 ID 3820

AUG 8 '56

D&A

County Edwards Elev. 2096
 Sec. 21 Twp. 26S Rgs. 16W
 Company N.C.R.A.
 FarmName Schultz No. 1

TOPS	DEPTH	LOG	DATUM	Loc. in Sec.
Anh.				NE NE SW
Tr.				
H.				
Tr.				
Dg.				
Bl.				
L.				Geol.
K.C.				Contr.
B.K.C.				Armer
Ce.				
C.				Pool
M.				
M.				Trousadle
K.				
Mz.				
Me.				
V.				
S.				
S.				
A.				
R.				
PE.				
G.				
TD.				

Date Comm. Loc. JUN 20 '56

6001 2 S MUL

[Signature]