


Edwards

KANSAS

SECTION 10 TOWNSHIP 26 RANGE 16W

WELL NO. #1 Hill

COMPANY Ambassador Oil

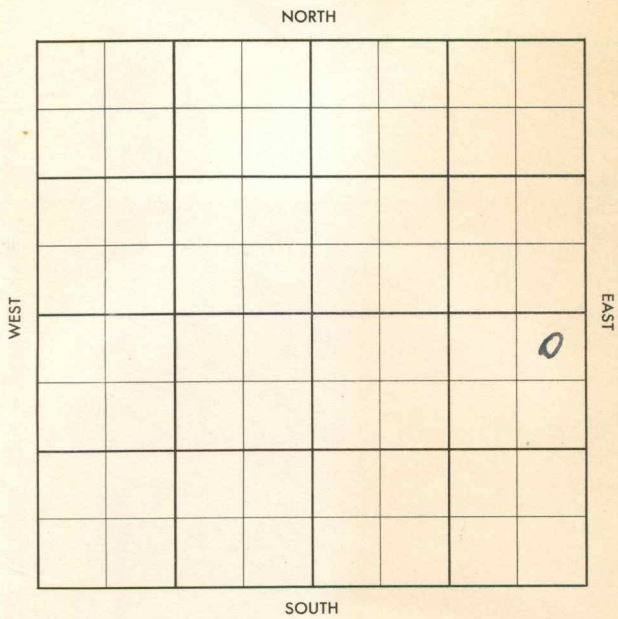

SOUTH

Edwards

SEC. 10 TWP. 26 R. 16W

WELL NO. #1 Hill FARM

COMPANY Ambassador Oil

CONTRACTOR Garvey

WILDCAT

Ft. from N. Line


Ft. from S. Line

Ft. from E. Line

Ft. from W. Line

NE NE SE

3/8 mile - SDX

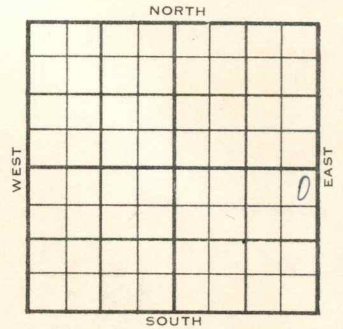

ELEVATION 1956 2050', 2059'. REPORT

- 4-25 Comm. 4-23-56
8" @ 269 w/ 300
Drlg. 550
- 5-3 Heeb. 3740
Br. lime 3891
Lans. 3907
Drlg. 4062'
- 5-10 Cong. 4363
Kh. 4406
Viola 4492
Arb. 4704
TD 4755
DST 4087-4115, op 1 hr. rec. 415' sw,
1440/30"
DST 4374-4462, op 1 hr. rec. 60' mud,
240/30"
DST 3875-3920, packer failed,
Waiting on orders
- 5-16 D&A
TD 4755'

ABANDONED

DX-78

County Edwards Elev. 2050 263-7
 Sec. 10 Twp. 26 Rge. 16W
 Company Ambassador Oil
 FarmName Hill No. 1

TOPS	DEPTH	LOG	DATUM	Loc. in Sec.
	3740			NE NE SE
Ug				
BL	3891			
L	3907			
K.C.				Geol.
B.K.C.				Contr
Ce.				Garvey
C.	4363			
M.				Pool
M.	4406			Wildcat
K.				
Mz.				
Me				
V.	4492			
S.				
S.				
A	4704			
R.				
Pe				
G.				
T.D.	4755			

ABANDONED

Date Comm. 4-23-56 MAY 16 1956
 8" @ 269/300 drlg. 550 MAY 2 '56 @ 4062
 MAY 0 " DST 4087-4115 lhr 415'
 SW FP 0-300 BHP 1446/30
 crd 4350-80 rec 29 1/2' crd 4410
 -62 Full. Rec DST 4374-4462
 lhr rec 60' Md BHP 240/30"
 DST 3875-3920 PKr Failed w.o.p.
 MAY 16 '56

D&A

County Edwards Elev. 2050
 Sec. 10 Twp. 26 Rge. 16W
 Company Ambassador Oil
 FarmName Hill No. 1

TOPS	DEPTH	LOG	DATUM	Loc. in Sec.
Anh.				NE NE SE
Tr.				
H.				
Tr.				
Dg.				
BL				
L.				Geol.
K.C.				Contr
B.K.C.				Garvey
Ce.				
C.				Pool
M.				Wildcat
M.				
K.				
Mz.				
Me				
V.				
S.				
S.				
A				
R.				
Pe				
G.				
T.D.				

3/4 mile
 FIRST REPORT
 APR 25 '56

Date Comm. 4-23-56
 8" @ 269/300 drlg. 550

MAY 5 1956

R.G.

25