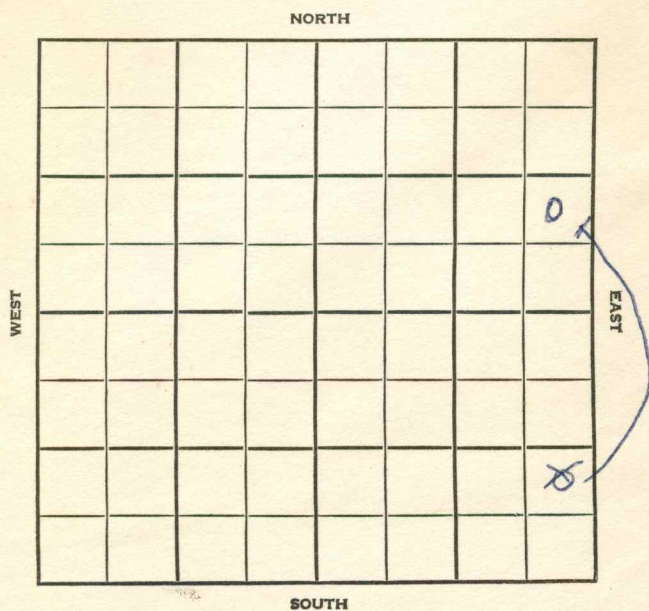


Section 11 Township 26 Range 16 WWell No. #1 O. SchulttzCompany Amerada Pet.

SEC. <u>11</u>	TWP. <u>26</u>	R. <u>16W</u>
WELL NO. <u>#1 O. Schulttz</u>		
COMPANY <u>Amerada Petr.</u>		FARM
CONTRACTOR <u>Barbour</u>		
<u>Salsar</u>		
_____ Ft. from N. Line		
_____ Ft. from S. Line		
_____ Ft. from E. Line		
_____ Ft. from W. Line		
NE SE ^{NE} SE		

WEST

SOUTH

NORTH

ABANDONED

SOUTH

3/4 mile - SDX

1956	ELEVATION	REPORT
	<u>2057</u>	
2-8	Location	
2-16	Spud 2-12-56 8 5/8" @ 313/400 Drlg. 1798'	
2-23	Drlg. 3790'	
3-1	Heeb. 3758, Tor. 3777, Doug. 3797 Br. Lime 3911, Lans. 3924, BKC 4242, Miss. 4378 Kh sh. 4413 Kh. sd. 4421 Viola 4498 DST 3925-35, op 2 hrs. rec 375' GIP, 65' socm, 60' sw, 790/20" DST 4377-90, op 2 hrs. rec 108' msw, 0/20" DST 4421-33, op 1 hr. rec. 60' msw, 30# Drlg. 4605	

CORRECTION

County Edwards Elev. 2057
 Sec. 11 Twp. 26 Rge. 16W
 Company Amerada Pet.
 Farm Name O. Schultz No. 1

TOPS	DEPTH	LOG	DATUM	Loc. in Sec.
Anh.				NE SE SE
Tr.				
H.	3258	3258		
Tr.	3227	3227		
Dg.	3292	3		
Bl.	3911	3911		
L.	3924	3925	1768	
K.C.				Geol.
B.K.C.	4242		2185	Contr.
Ce.				Barbour
C.				
M.	4378	4378	2321	Pool
M.				Salser
K.	4413	4412	2355	
M. K. sd	4421	4421-522364		
M.				
V.	4498	4496	2439	
S.	4619	4632	2575	
S.	4660	4657-852600		
A.	4716	4716	2659	
R.				
PE.				
G.				
TD.	4255			

Date Comm. MAR 7 1956

Location FEB 15 '56 2-12-56 22

3131400 ID 1798 FEB 22 '56

ID 3790 FEB 20 '56 DST 3925-35

2 hrs 375' BHP rec 65'

SACM + 60' SW FP 0-75'

BHP 790/20 DST 4377-9

2 hrs rec 108' MSW FP

BHP 0/20 DST 4421-33 1

rec 60' MSW BHP 30 0+

County Edwards Elev. 2057
 Sec. 11 Twp. 26 Rge. 16W
 Company Amerada Pet.
 Farm Name O. Schultz No. 1

TOPS	DEPTH	LOG	DATUM	Loc. in Sec.
Anh.				NE SE SE
Tr.				
H.				
Tr.				
Dg.				
Bl.				
L.				Geol.
K.C.				Contr.
B.K.C.				Barbour
Ce.				
C.				
M.				Pool
M.				Salser
K.				
Mz.				
Mq.				
V.				
S.				
S.				
A.				
R.				
PE.				
G.				
TD.				

Date Comm.

Location

3/4 mile

FIRST REPORT

FEB 3 '56

25

MAR 7 '56

DST 4718.55 1hr
rec 240' MSW + 520' SW
BHP 1440/20" Ran 49.

N.E. a

R.G.

MAR 19 1956

CORRECTION