

Edwards


KANSAS

SECTION 31 TOWNSHIP 26 RANGE 16 W

WELL NO. # 1 Ira Tam

COMPANY D.R. Lauck & SDX

NORTH

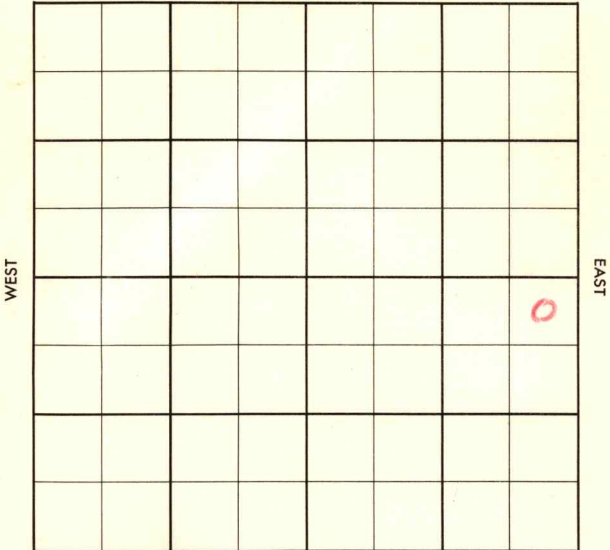

SOUTH

HOT FILE Edwards KANSAS

SEC. 31 TWP. 26 S R. 16 W


WELL NO. # 1 Ira Tam FARM

COMPANY D. R. Lauck Oil (EXPLORATORY-OBOD)

CONTRACTOR & SDX Lauck

Wildcat

_____ FT. FROM N. LINE
 _____ FT. FROM S. LINE
 _____ FT. FROM E. LINE
 _____ FT. FROM W. LINE

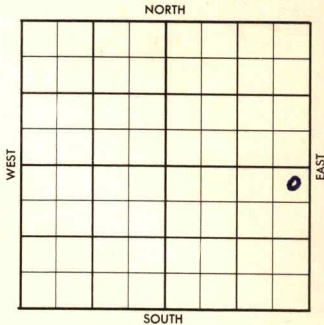

NE NE SE

No Contract Reid
Don't advise Contract
 (TWH6-F011) *See*

1956 ELEVATION 2102' DF 2099' GR REPORT 2104' KB

4700' Viola Test

8/31	Spudded 8-30-56	
	Drlg. 200'	(DR#171)
8/31	Spudded 8-30-56	(FR Tkt)
9/1	Set 8-5/8" @ 326 w/235 sax.	
9/2	Drlg. 1485'	(Card-D.R. Lauck Oil)
9/3	Drlg. 2070'	"
9/4	Drlg. 2425'	"
9/5	Drlg. 2700'	"
9/6	Drlg. 3020'	"
9/7	Drlg. 3315'	"
9/8	Drlg. 3500'	"
9/9	Drlg. 3711'	"
9/10	Drlg. 3980'	"
9/11	Drlg. 4131'	"
9/12	Drlg. 4275'	"
9/13	Drlg. 4393'	"
	Drlg. 4517'	
	T. Heebner 3879	
	T. Brown lime 4030	
	T. Lansing 4044	
	Base KC 4391'	"
9/14	Drlg. 4639'	"
	T. Miss. 4544'	
	T. Kinderhook 4603'	"
9/15	TD 4732'. D & A	(Card-DRLauck Oil)
9/17	TD 4732'. Plugged & Abandoned.	(DR#181)

1956

9/26

Received copies of Geological report
& drilling time log; Driller's log;
Plugging record; and Halliburton
Radiation Guard Log. -

9/26

Commenced 8-30-56

Completed 9-15-56

8-5/8" @ 326 w/200 sax.

Driller's Log: Dakota sand 375',
Anhydrite 1125', Brown Lime 2785'

Sample tops: Heebner 3879',

Brown lime 4030', Lansing 4044',

Base KC 4376', Miss. 4544',

Kinderhook shale 4620', Kinderhook
sand 4639', Viola 4669'

Halliburton Tops: Heebner 3878',

Brown Lime 4030', Lansing 4042',

Base KC 4372', Miss. 4542',

Kinderhook shale 4623', Kinderhook
sand 4639', Viola 4669'

Rotary TD 4732' D & A.

(See copy of Driller's Log. and
Well plugging record.)

9/19

Comm. 8-30-56

Comp. 9-15-56

TD 4732'. D & A

No shows No tests.

ABANDONED

County Edwards Elev. 2102
 Sec. 31 Twp. 26 Rge. 16W
 Company D. R. Lauck & Sunray Mid-Continer
Ira Tam No. 1

	DEPTH	LOG	DATUM	Loc. in Sec.
				NE NE SE
Tp.				
H.	3890	3878		
Tr.				
Dg.				
Bl.	4030	4030		
L.	4044	4042		
M.C.				Geol.
B.K.C.	4391	4372		Contr.
Ce.				Lauck
C.				
M.	4544	4542		
M.				Pool
K. sh	4603	4623		Wildcat
Mz.				
Ma.				
V.		4669		
S.				
S.				
A.				
R.				
Pe.				
G.				
TD.	4732			

Date Comm. 8-30-56

8" @ 326/200 drlg. 2510 SEP 12 '56 H6

3890 BL 4030 L59 4044 ϕ 4280

SEP 19 '56 X BKC 4391 Miss 4544 Kd sh

4603 RTD 4732 Log D&A

No shows no test.

D&A



County Edwards Elev. _____
 Sec. 31 Twp. 26 Rge. 16W
 Company D. R. Lauck & Sunray Mid-Continent
 Farm Name Ira Tam No. 1

Co.

Lse.

No.

Sec.

T.

R.

TOPS	DEPTH	LOG	DATUM
Anh.			
Tp.			
H.			
Tr.			
Dg.			
Bl.			
L.			
K.C.			
B.K.C.			
Ce.			
C.			
M.			
M.			
K.			
Mz.			
Mo.			
V.			
S.			
S.			
A.			
R.			
P.C.			
G.			
T.D.			

Loc. in Sec.

NE NE SE

Geol.

Contr.

Lauck

Pool

Wildcat

FIRST REPORT	
SEP 5 '56	

Date Comm. 8-30-56
8" @ 326/200 drlg. 2510

215

M.M.