

TWH7-BH3V Edwards

KANSAS

SECTION 35 TOWNSHIP 26S RANGE 16W

WELL NO. #1 Phillips

COMPANY D.R. Lauck (SDX - $\frac{1}{2}$ Int.)

NORTH

NE SE NE

SOUTH

WEST

EAST

(Handwritten mark: a circle with a diagonal line through it, located in the 7th row, 7th column of the grid.)

HOT FILE

Edwards

KANSAS

SEC. 35 TWP. 26 S R. 16 W

WELL NO.

1 Phillips

FARM

COMPANY

D.R.Lauck Drlg. Co. & SDX (EXPLORATORY-OBOD)

CONTRACTOR

D.R.Lauck Drlg.


Wildcat

_____ FT. FROM N. LINE

_____ FT. FROM S. LINE

_____ FT. FROM E. LINE

_____ FT. FROM W. LINE

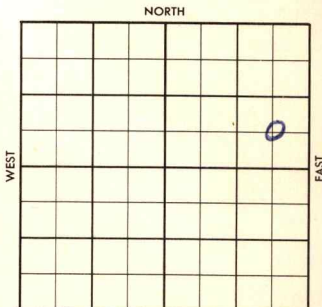

^c
~~NE~~ SE NE

SDX-1/2 Int.

*In Book
No Contract*

1957 ELEVATION 2081' KB REPORT (TWH7-BH3) ✓

11/6	MIRT	(FR Tkt)
11/5	Spudded 11-4-57	
	8-5/8" @ 326 w/225 sks. (Card-DR Lauck)	
11/6	Drlg. 950'	"
11/8	Drlg. 1028'	(DR#219) "
11/9	Drlg. 1560'	"
11/10	Drlg. 2190'	"
11/11	Drlg. 2500'	"
11/12	Drlg. 2820'	"
11/13	Drlg. 2820' 3190'	"
11/14	Drlg. 3460'	"
11/15	Drlg. 3715'	"
11/16	Drlg. 3980'	"
11/17	Drlg. 4155'	"
11/18	Drlg. 4300'	"
11/19	Drlg. 4440'	"
11/20	Drlg. 4440'	"
11/21	Drlg. 4535'	"
11/22	TD 4560'. Prep to DST.	"
11/25	Drlg. @ 4065' 4605'	
11/26	TD 4680'. P & A ✓	(DR#231)

OVER

1957
11/27

Spud 11-4-57

8-5/8" @ 320/225

Hb 3824', Tr. 3844', Dg 3867',

BL 3978', Lsg 3994'

DST 4130-55, 60", rec 35' M. FP 0

BHP 1315 B KC 4327' Marm 4340'

Ce Sh 4437'

DST 4453-65, open 60", rec 15' M

All pressures 0#. Miss 4495'

DST 4497-4541' (60") rec 60' gassy mud

FP 50-60# IBHP 510#. FBHP 240# 30"

Kinderhook Sd 4551'

DST 4551-60' (45") rec 15' M

BHP 70#

DST 4560-4605', (60") rec 50' M.

FP 35-55# BHP 370# 20".

Viola 4604'

TD 4685' Log tops: D & A

Log tops: Hb 3824', Tr 3843',

Dg 3868', BL 3979', Lsg 3994',

BKC 4328', Mar 4336', Ce Sh 4432',

M 4495', K 4554', V 4605'

(Scout Completion ticket)

ABANDONED

~~25~~
CORRECTION

S-513-A

ABANDONED

Edwards

ELEV. 20790

NOV 27 '57

35

TWP. 26 RGE. 10

COMPANY

D.R. Truck

NO. 1

~~INT.~~

~~SMC~~

SDX

FARM

Phillips

(TWM7-BH3)✓

LOC.

~~NE 1/4~~

L.S.
C same

Log TOPS

Hb 3924

TR 3843

Dg 3868

BL 3979

Lsg 3994

BKL 4329

Mar 4336

Co Sh 4432

M 4495

K 4554

V 4605

Rec 35' M FPO BHP 1315 BKL

4327 Mar m 4340 ϕ 4391

X Co Sh 4437 ~~Miss 4495~~

DST 4453-65 ϕ 60" rec 15'

M all pressures O Miss 4495

DST 4497-4541 60" rec 60'

gang M FPO 50-60 IBHP 510

F BHP 240/30" Kinderhook

sd 4551 ~~into 4624~~ DST

4551-60 45" rec 15' M

BHP 70 DST 4560-4605

60" rec 50' M FPO 35-55

BHP 370/20" ~~TD 4685~~

V 1012 4604

TD 4685

Log TOPS

D & A

~~KINK~~
~~WILDCAT~~
~~25~~

S-513-A

CO. ~~Edwards~~ ELEV. _____

SEC. ~~35~~ TWP. ~~26~~ RGE. ~~16W~~

COMPANY ~~D.R. Lauck~~ NO. ~~1~~

NOV 6 '57

FIRST REPORT

~~SPX-~~ ~~K~~ INT.

FARM ~~Phillips~~

LOC. ~~NE SE NE~~

GEOL. _____

CONTR. ~~Co. Tools~~

POOL ~~Wildcat~~

SPUD _____

~~MIRT~~

CO.

LSE.

NO.

SEC.

TWP.

RGE.