

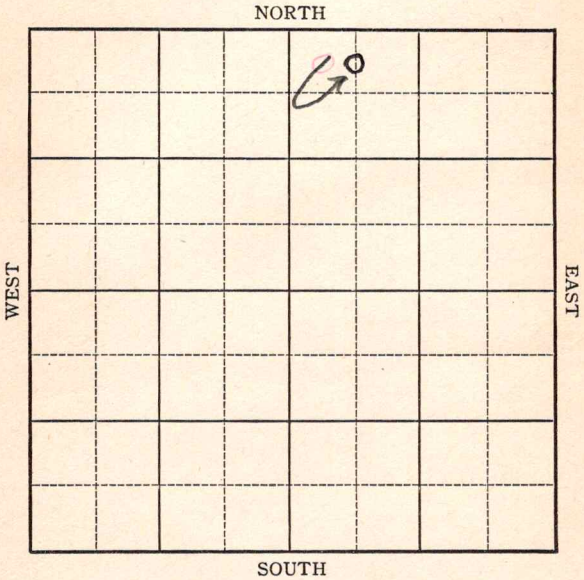
KANSAS

Edwards

Section 29 Township 26 Range 16W

Well No. #1 Perrett

Company W N Bannenburg et al



KANSAS

Edwards County

Sec. 29 Twp. 26 R. 16W

Well No. #1 Perrett Farm

W. N. Bannenburg et al. Company

Wildcat

NORTH

330 Ft. from N. Line

Ft. from S. Line

Ft. from E. Line

660
~~330~~ Ft. from W. Line

WEST

EAST

SOUTH

CNL NW NE E/V. 2092

1944

REPORT

OFFSET

7/19

Rotary

7/25

Spudded 7/23/44 10" at 800'
Drlg. 1005' on 7/24/44 (Tel)

8-3

Drilling 3345' (Telegram)

9-3

Drilling 3495' (Tel)

8/4

Drlg. 3647' (Tel)

8/5

Drilling 3861' (Telegram)

8-7

Drilling 3992' (Tel)

8-8

Drilling 4060'.

Topped Lansing 4033

**Running 20' lower than dry hole in
Section 27. (Telegram)**

8-10

Drilling 4174' (Tel)

8-11

Drilling 4300' (Tel)

8-14

Drilling 4611' (Tel)

8-15

Drilling 4658' (Tel)

8-16

Drilling 4665' (lime. green)

**Viola Lime topped at 4650-no shows.
(Telegram)**

8-17

Simpson 4763

Arbuckle 4847

Drilling 4850 - no shows. (Telegram)

8-18

Total Depth 4896'

Ran Schlumberger.

Shut down for orders. (Telegram)

8/23

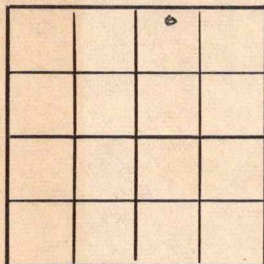
Arb 4846

TD 4896

ABANDONED

Pool Name WildcatMap No. 84 Sec. 29 Twp. 26 R. 16 WWell No. 1 PerretW. N. Dannenburg et al. Company**ABANDONED**

Contractor

C N L NW NE**SECTION PLAT**330 Ft. from N. Line

Ft. from S. Line

Ft. from E. Line

660 Ft. from W. LineEdwards County

Location

Rig up

Drilling and Remarks:

Cr 84846**RECORD**

Cased _____ in., _____ ft.

Sand _____

Gas _____

Oil _____

Total Depth 4896**PRODUCTION**

1st 24 hrs. Nat. _____

1st 24 hrs. after shot _____

Gas _____ Cu. Ft.

Dry Hole _____

Abandoned _____

Date

AUG 23 1944

19

S. J. LEWIS

Scout

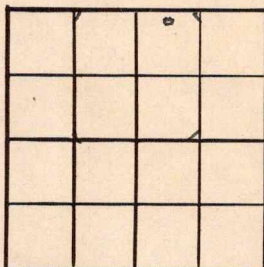
Pool Name WildcatMap No. 8 Sec. 29 - Twp. 26 R. 16WWell No. 1 PerrettW. N. Dannenburg et al. Company

CORRECTION

Contractor

C N L NW NE

SECTION PLAT

330 Ft. from N. Line

Ft. from S. Line

Ft. from E. Line

660 Ft. from W. LineEdwards County

Location

Rig up

Drilling and Remarks:

Reported

NW NE

RECORD

Cased _____ in., _____ ft.

Sand _____

Gas _____

Oil _____

Total Depth _____

PRODUCTION

1st 24 hrs. Nat. _____

1st 24 hrs. after shot _____

Gas _____ Cu. Ft.

Dry Hole _____

Abandoned _____

Date

AUG 2 1944 19S. J. LEWIS Scout

KANSASPool Name WildcatMap No. 84 Sec. 29 Twp. 26 R. 16WWell No. 1 PerrettW.N. Bannenburg et al. CompanyFIRST REPORT

Contractor

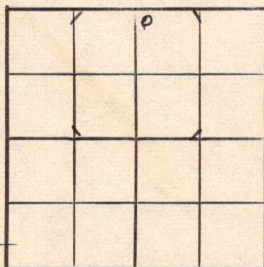
NW NE

SECTION PLAT

330 Ft. from N. Line

Ft. from S. Line

Ft. from E. Line

330 Ft. from W. Line*"offset"*Edwards County

Location _____

Rig up _____

Drilling and Remarks:

Rotary

RECORD

Cased _____ in., _____ ft.

Sand _____

Gas _____

Oil _____

Total Depth _____

PRODUCTION

1st 24 hrs. Nat. _____

1st 24 hrs. after shot _____

Gas _____ Cu. Ft.

1st Dry Hole _____

Abandoned _____

Date

JUL 19 1944

19

S. J. LEWIS Scout

CLASS OF SERVICE

This is a full-rate Telegram or Cablegram unless its deferred character is indicated by a suitable symbol above or preceding the address.

WESTERN UNION

A. N. WILLIAMS
PRESIDENT

1201

(170#)

KW

SYMBOLS

DL = Day Letter

NL = Night Letter

LC = Deferred Cable

NLT = Cable Night Letter

Ship Radiogram

The filing time shown in the date line on telegrams and day letters is STANDARD TIME at point of origin. Time of receipt is STANDARD TIME at point of destination

KMA114 28 COLLECT=WICHITA KANS 17 947A

SAM BAIRD=

1944 AUG 17 AM 10 14

39 1105 MIDCONTINENT BLDG TUL=

DANNENBURG ONE PERRETT TWENTY NINE TWENTY SIX SIXTEEN WEST
EDWARDS COUNTY SIMPSON FORTY SEVEN SIXTY THREE ARBUCKLE FORTY
EIGHT FORTY SEVEN DRILLING FORTY EIGHT FIFTY NO SHOWS=

S J LEWIS.

File in envelope

*On card
Betsy*

Perrett #1
NW/4 NE/4 Section 29-26S-16W
Edwards County, Kansas
W. N. Dannenberg

file

Commenced: July 21, 1944
 Completed: August 18, 1944

Surface sand and gravel	0	435
Sandy red bed	435	560
Red bed	560	675
Sand and red bed	675	750
Red bed and shells	750	1005
Shale	1005	1010
Shale and shells	1010	1725
Salt and shale	1725	1905
Shale and lime	1905	2000
Lime	2000	2110
Anhydrite	2110	2165
Lime	2165	2200
Lime and shale	2200	2530
Lime	2530	2585
Shale and lime	2585	3345
Cherty lime	3345	3350
Lime	3350	3420
Lime and shale	3420	3627
Cherty lime	3627	3641
Lime	3641	3647
Shale and lime	3647	4039
Lime, K. C.	4039	4061
Cherty K. C. lime	4061	4097
Lime, rather firm	4097	4098
Cherty lime	4098	4130
Lime and shale	4130	4174
K. C. Lime	4174	4279
Lime and shale	4279	4480
Cherty conglomerate	4480	4571
Shale and chert	4571	4580
Cherty shale and lime	4580	4611
Shale and lime	4611	4650
Lime, viola	4650	4658
Lime and chert	4658	4707
Lime	4707	4744
Shale and lime	4744	4794
Shale, sandy	4794	4846
Arbuckle	4846	4896
TOTAL DEPTH		4896

Casing Record:

10 3/4" casing set at 800' and cemented
 with 325 sacks cement

STATE OF OKLAHOMA)
 COUNTY OF TULSA) ss.

I hereby affirm that the above and foregoing is a true and correct
 copy of the log of your Perrett Well No. 1, located in the Northwest Quarter of the Northeast
 Quarter of Section 29, Township 26 South, Range 16 West, Edwards County, Kansas.

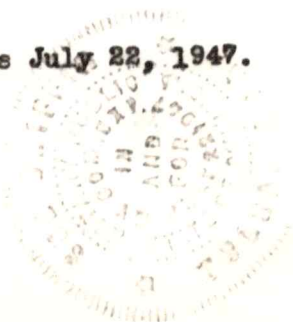
HELMERICH & PAYNE, INC.

By *William Good Hunt*
 Treasurer

Subscribed and sworn to before me, a Notary Public, this 21st day of August, 1944.

Sue Griffin
 Notary Public

My commission expires July 22, 1947.



TIME LOG

W. N. Dannenburg No. 1 Perrett, C N $\frac{1}{2}$ NW NE of Section 29-26S-16W,
Edwards County, Kansas.

DEPTH		DRILLING TIME		ACTUAL TIME	REMARKS
From	To	Began	Ended		
3300	3310	9:15	10:46	5-6-7-6-6-8-10-12-14-17	
	3320	12:25	3:37	15-17-15-13-11-11-10-10-7-9	
	3330	3:37	5:57	10-11-14-13-14-12-12-10-9-8	
	3340	5:57	7:02	8-6-5-5-6-6-10-6-7-6	
	3350	7:02	8:25	6-7-7-7-7-11-6-11-15-6	Trip @ 50
	3360	2:30	3:16	4-3-5-3-3-3-2-2-6-9	
	3370	3:16	4:45	7-8-9-11-13-9-7-7-8-10	
	3380	4:45	5:58	9-7-6-7-8-7-6-8-8-8	
	3390	5:58	8:08	7-9-8-9-7-8-6-7-6-7	
	3400	8:08	9:20	7-7-9-7-7-8-7-6-8-6	Little Rough @ 98
3400	3410	9:20	10:31	7-6-6-7-7-6-8-7-10-7	
	3420	10:31	11:49	8-8-7-6-6-8-7-5-8-9	
	3430	11:49	12:49	7-12-8-3-4-4-4-4-4-6	
	3440	12:49	2:13	6-8-8-8-7-8-7-9-13-10	
	3450	2:13	3:34	10-11-10-8-7-5-6-6-6-5	
	3460	3:34	4:40	6-5-6-6-8-8-8-8-6-5	
	3470	4:40	5:26	5-4-4-4-6-4-5-5-5-4	
	3480	5:26	6:37	4-3-4-5-8-8-9-8-8-7	
	3490	6:37	7:39	8-8-5-5-5-5-5-4-6-11	S.R. 87-88
	3500	7:39	8:38	8-4-2-2-6-4-6-9-9-9	
3500	3510	8:38	10:41	9-13-11-11-6-7-5-7-8-11	
	3520	10:41	11:35	4-3-3-6-9-6-6-6-6-5	
	3530	11:35	12:09	4-4-5-3-5-3-3-2-2-3	S.R. 29
	3540	12:09	12:58	2-3-3-4-4-2-3-3-5-5	
	3550	12:58	2:00	4-4-5-5-6-8-8-8-7-7	
	3560	2:00	2:51	6-3-5-5-5-5-5-7-5-6	
	3570	2:51	4:15	6-9-4-6-11-7-5-5-4-6	
	3580	4:15	5:20	4-4-4-5-9-13-13-4-5-4	
	3590	5:20	6:22	4-3-3-3-6-6-6-8-11-11	
	3600	6:22	8:24	8-5-5-6-7-7-6-8-9-7	
3600	3610	8:24	9:06	5-5-3-4-4-4-4-4-4-5	Little Rough @ 06
	3620	9:06	10:41	5-5-5-8-13-16-12-9-10-12	
	3630	10:41	12:47	14-10-10-9-9-8-6-8-15-22	Trip @ 30
	3640	5:52	7:09	7-8-9-7-8-7-9-7-7-8	Rough
	3650	7:09	7:55	6-5-6-4-4-5-3-3-5-5	
	3660	7:55	9:06	5-5-6-7-7-3-4-6-5-7	
	3670	9:06	9:44	4-3-2-4-3-3-3-4-4-8	
	3680	9:44	11:10	6-7-7-11-11-11-10-8-7-8	
	3690	11:10	12:37	8-12-11-9-7-8-10-6-4-4	
	3700	12:37	1:18	3-4-4-6-3-4-5-4-4-4	
3700	3710	1:18	1:52	3-3-4-4-3-3-4-3-3-4	
	3720	1:52	3:16	5-6-13-11-6-5-4-4-6-6	
	3730	3:16	4:02	4-6-5-4-6-5-5-4-4-3	
	3740	4:02	5:18	4-7-7-6-7-8-10-11-9-7	
	3750	5:18	7:19	7-7-6-7-6-6-7-7-8-7	
	3760	7:19	8:26	6-6-6-7-7-8-7-7-7-6	
	3770	8:26	9:25	5-6-6-6-6-7-7-6-5-5	
	3780	9:25	10:12	4-4-6-5-4-5-4-4-3-2	
	3790	10:12	10:49	3-3-2-3-4-5-4-5-5-4	
	3800	10:49	11:29	4-3-4-4-4-4-4-5-4-4	
3800	3810	11:29	12:05	3-2-2-2-2-2-4-4-4-3	
	3820	12:05	12:29	2-2-3-2-2-2-2-4-2-3	
	3830	12:29	1:32	3-4-6-9-9-7-5-4-6-10	
	3840	1:32	3:52	11-11-11-9-3-4-7-9-10-14	
	3850	3:52	5:19	12-12-11-10-8-9-8-5-5-7	
	3860	5:19	7:27	15-13-13-16-15-12-11-10-11-12	
	3870	7:27	9:25	12-16-9-10-9-9-12-10-10-5	
	3880	9:25	10:25	6-5-4-5-5-10-7-6-5-7	R @ 73
	3890	10:25	12:39	6-6-8-6-6-5-8-8-10-14	
	3900	12:39	7:50	7-15-5-5-5-4-6-8-5-5	
3900	3910	7:50	10:47	5-7-7-7-8-7-5-5-6-6	
	3920	10:47	11:51	7-5-7-6-6-7-6-7-7-6	

DEPTH		DRILLING TIME		ACTUAL TIME	REMARKS
From	To	Began	Ended		
3920	3930	11:51	12:42	6-6-5-5-5-5-5-4-5	S.R. 22 to 24
	3940	12:42	1:50	5-5-5-5-6-5-6-6-7	
	3950	1:50	2:43	6-4-5-7-6-5-5-5-5	
	3960	2:43	3:36	5-5-5-6-5-6-6-5-5	
	3970	3:36	5:46	6-5-6-5-6-5-6-6-5	
	3980	5:46	6:39	5-6-5-6-5-6-6-5-6	
	3990	6:39	7:33	5-5-5-4-5-5-4-5-5	
	4000	7:33	9:06	11-7-9-7-7-8-5-5-4	
	4010	9:06	10:05	1-5-5-5-5-5-5-8-9	
	4020	10:05	11:40	11-10-11-10-10-9-9-5-10-10	
4000	4030	11:40	2:19	5-5-5-6-6-8-9-9-9-8	S.R. 33 S.R. 99 & 4000 S.R.
	4040	2:19	4:20	7-8-10-8-6-7-6-8-6-10	
	4050	4:20	6:15	11-9-11-14-17-15-12-8-8-10	
	4060	6:15	8:52	8-8-16-15-16-19-18-15-15-14	
	4070	8:52	9:35	18-3-10-12-7-11-10-14-13-13	
	4080	9:35	11:56	14-9-12-17-19-14-19-15-10-12	
	4090	11:56	1:52	10-11-12-9-14-11-8-9-8-13	
	4100	1:52	12:08	17-14-14-12-16-17-27-30-6-7	
	4110	12:08	1:51	11-12-11-11-8-10-9-12-9-10	
	4120	1:51	3:48	9-9-9-8-8-8-8-10-9-8	
4100	4130	3:48	5:09	8-7-7-6-7-8-8-7-11-12	Trip @ 61 Rough Rough Trip @ 97 Rough Rough 14 to 20 Trip @ 30
	4140	12:31	2:07	9-7-14-14-12-10-7-8-8-7	
	4150	2:07	2:50 $\frac{1}{2}$	6-2-1-2-2-2-1- $\frac{1}{2}$ - $\frac{1}{2}$ - $\frac{1}{2}$	
	4160	2:50 $\frac{1}{2}$	4:48	$\frac{1}{2}$ -7-11-14-14-14-13-13-115-16	
	4170	4:48	6:56	16-14-12-10-11-16-8-12-15-13	
	4180	6:56	8:59	13-9-10-11-13-10-9-11-8-13	
	4190	8:59	9:45	12-10-7-8-11-1-1-2-3	
	4200	9:45	10:30	3-3-7-7-4-4-6-4-3-4-	
	4210	10:30	11:17	4-3-3-3-2-2-2-1-3-5	
	4220	11:17	12:38	8-10-10-10-11-8-6-5-5-8	
4200	4230	12:38	2:37	8-14-13-11-15-10-11-13-13-13	Rough Rough S.R. Rough 57 & 60 Trip @ 80
	4240	2:37	4:34	12-5-4-10-6-12-13-8-12-14	
	4250	4:34	6:34	13-11-13-12-10-13-14-13-11-10	
	4260	6:34	7:53	11-9-10-7-7-7-7-6-7-8	
	4270	7:53	9:35	6-6-12-12-10-10-11-12-7-9	
	4280	9:35	12:02	11-12-14-14-13-13-11-13-16-30	
	4290	4:32	6:06	15-10-10-8-8-10-8-8-9-8	
	4300	6:06	7:46	10-11-10-9-10-9-8-7-8-9	
	4310	7:46	9:12	17-8-6-7-8-6-6-9-9-10	
	4320	9:12	10:40	6-8-7-9-10-8-8-10-10-12	
4300	4330	10:40	12:19	9-10-11-11-9-11-11-10-10-8	Rough @ 68
	4340	12:53	2:23	11-12-10-10-8-8-7-10-9-9	
	4350	2:23	3:55	7-8-9-7-9-11-10-10-9-9	
	4360	3:55	5:15	8-7-7-10-9-7-7-7-6-7	
	4370	5:15	6:54	6-9-10-10-10-9-8-11-10-7	
	4380	6:54	8:17	9-9-7-10-9-9-8-8-7-8	
	4390	8:17	9:50	9-9-10-9-9-10-10-9-8-10	
	4400	9:50	11:31	10-8-10-9-10-12-9-10-9-8	
	4410	11:31	1:13	9-11-6-8-9-10-9-11-13-10	
	4420	1:13	3:14	9-12-13-13-9-11-14-15-13-12	
4400	4430	3:14	5:11	10-9-11-12-13-11-11-11-9-10	Trip @ 71 Rough 86 to 90 Rough Trip @ 95 Rough S.R. 26 to 30 Rough 33 to 336 Trip @ 53 S.R. Trip @ 77
	4440	5:11	7:13	10-11-12-12-12-12-10-9-10-8	
	4450	7:13	8:42	6-9-8-10-9-10-12-10-8-7	
	4460	8:42	11:00	8-13-11-12-16-13-12-12-11-12	
	4470	11:00	1:10	13-13-15-14-13-14-11-11-11-15	
	4480	1:10	9:03	15-8-10-17-13-10-9-9-10-7	
	4490	9:03	10:32	8-6-8-10-11-9-8-9-7-5	
	4500	10:32	4:23	3-3-4-5-9-5-4-5-4-6	
	4510	4:23	5:10	3-4-5-5-5-7-5-4-5-4	
	4520	5:10	6:06	3-5-5-4-5-4-4-5-4-6	
4500	4530	6:06	6:59	6-6-5-6-5-5-5-5-5-5	Trip @ 53 S.R. Trip @ 77
	4540	6:59	7:59	6-5-4-5-3-4-5-6-10-12	
	4550	7:59	9:11	4-4-4-6-6-3-12-8-5-5	
	4560	9:11	3:10	7-6-14-2-3-7-3-2-5-3	
	4570	3:10	3:51	3-4-4-4-3-2-3-5-7-6	
	4580	3:51	11:32	9-9-19-20-24-24-25-8-10-9	

DEPTH		DRILLING TIME		ACTUAL TIME	REMARKS
From	TO	Began	Ended		
4580	4590	11:32	1:06	16-8-5-9-9-9-9-7-8-9	
	4600	1:06	2:23	10-9-9-9-10-9-7-4-3-8	
4600	4610	2:23	3:51	7-7-5-5-5-6-9-11-9-14	
	4620	3:51	12:47	9-13-12-16-8-20-12-14-16-12	
	4630	12:47	3:00	14-14-15-14-11-12-14-15-12-12	
	4640	3:00	5:48	10-7-8-11-11-14-15-17-18-18	
	4650	5:48	8:15	17-15-15-13-12-15-15-15-15-14-16	
	4660	8:15	8:30	5-6-3-7-6-11-14-16-6-10	Trip @ 58
	4670	8:30	12:03	9-10-8-6-5-5-5-12-11-15	
	4680	12:03	2:16	14-12-15-13-13-13-14-11-14-14	
	4690	2:16	9:20	13-16-19-19-19-22-21-6-8-9	Trip @ 87
	4700	9:20	10:50	8-10-10-7-8-7-7-8-8-10	
4700	4710	10:50	12:20	7-8-9-8-10-9-8-11-9-11	
	4720	12:20	2:23	12-9-11-10-12-12-13-14-13-12	
	4730	2:23	4:45	13-12-13-13-15-13-14-13-14-10	
	4740	4:45	6:50	11-13-14-13-14-13-11-12-12-12	
	4750	6:50	9:01	11-12-14-12-17-14-12-12-14-13	
	4760	9:01	11:58	15-12-14-13-13-10-10-11-13-12	
	4770	11:58	2:23	16-16-26-15-12-18-16-10-8-8	
	4780	2:23	9:37	9-10-11-21-5-6-5-5-6-7	Trip @ 74
	4790	9:37	11:10	8-10-8-11-8-7-8-9-8-8	
	4800	11:10	12:13	7-8-8-8-7-7-6-4-4-4	
4800	4810	12:13	1:11	4-4-4-5-5-9-2-5-9-8	
	4820	1:11	2:52	9-10-9-10-10-8-8-10	
	4830	2:52	4:45	11-11-12-11-11-10-10-12-13-12	
	4840	4:45	6:34	11-12-12-12-10-9-9-11-11-12	
	4850	6:34	8:49	15-12-11-8-13-15-9-9-8-10	
	4860	8:49	10:32	10-12-10-10-10-9-8-10-14-10	
	4870	10:32	12:33	12-9-14-13-15-12-11-10-13-12	
	4880	12:33	2:48	14-10-13-12-12-14-16-15-15-14	
	4890	2:48	5:20	12-12-16-16-15-19-16-11-12-13	
	4896	5:20	6:45	15-11-11-16-16-16	

Total Depth