


DX 78-1 Edwards

KANSAS

Section 28 Township 26 Range 16W

Well No. #1 Simpson

Company Aurora Gasoline Co

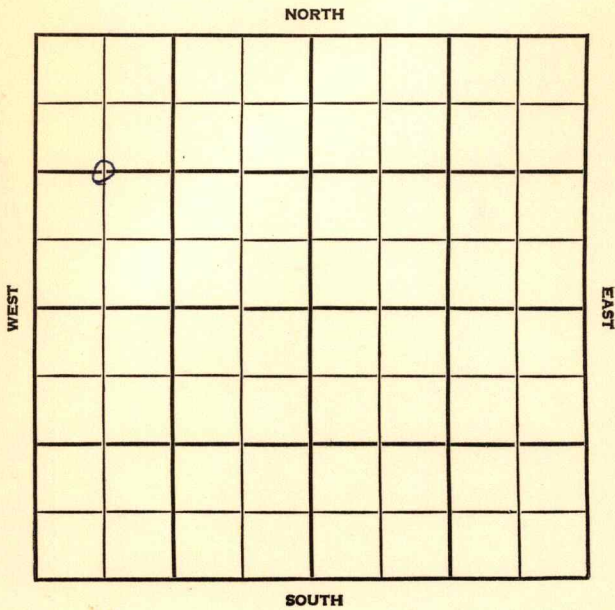

Edwards

KANSAS

SEC. 28	TWP. 26	R. 16W
------------	------------	-----------

WELL NO.

#1 Simpson

FARM

COMPANY

Aurora Gasoline Co.

CONTRACTOR


Smitherman T.

_____ FT. FROM N. LINE

_____ FT. FROM S. LINE

_____ FT. FROM E. LINE

_____ FT. FROM W. LINE

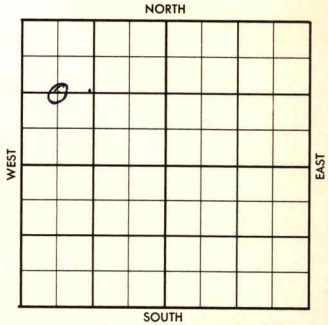

C W 12 NW

$\frac{1}{4}$ MILE - SDX

Rains & Williamson-FO

	ELEVATION	REPORT
1956		
8-29	Location	
9-6	Loc 174 A	

Co.

County EdwardsElev. 2091Sec. 26 Twp. 26Rgs. 16WCompany Aurora Gasoline Co.Farm Name SimpsonNo. 1

	DEPTH	LOG	DATUM
R.	3834	3826	
Tr.		3984	
Dg.	3989	3989	
BL.	4005	4004	
L.			
K.C.	4235	4335	
B.K.C.	4440	4440	
Ce. <u>sh</u>			
C.	4477	4477	
M.			
M.			
K. <u>sh</u>		4534	
Mz.			
Ma.			
V.		4548	
S.			
S.			
A.			
R.			
Pe.			
G.			
T.D.	4572		

Loc. in Sec. 0 W/2 1WGeol. Griffithman T.Concr. Pool gas area

SEP 26 '56

1/4 mile

ABANDONED

Loc.

No.

Date Comm. SEP 5 '56

Sec.

T.

R.

Rains & Williamson (P.O.)

loc SEP 5 '56 SEP 12 '56 9-9-5685/8 400/450 ϕ 3520 SEP 19 '56

DST 4460-95 or 90" G 1/4"

rec 130' GCM BHP 320/20

DST 4500-72 SEP 26 '56 or 2 hrs

120' Md BHP 540/30"

D&A

County Edwards

Elev. _____

Sec. 28 Twp. 26 Rge. 16WCompany Aurora Gasoline Co.Farm Name SimpsonNo. 1

TOPS

DEPTH

LOG

DATUM

Loc. in Sec. _____

Anh.

C W/2 NW

Tp.

H.

Tr.

Dg.

Bl.

L.

K.C.

Geol. _____

B.K.C.

Contr. _____

Ce.

C.

Smitherman T.

M.

Pool _____

M.

K.

Mz.

Ma.

V.

S.

S.

A.

R.

Pe.

G.

T.D.

FIRST REPORT

AUG 29 '56

Date Comm. _____

Rains & Williamson (FO)loc.28

SEP 2 1956

R.G.