


Section 28 Township 26 Range 16WWell No. #1 Meller (Mellor)Company Sinclair Oil & Gas

NORTH

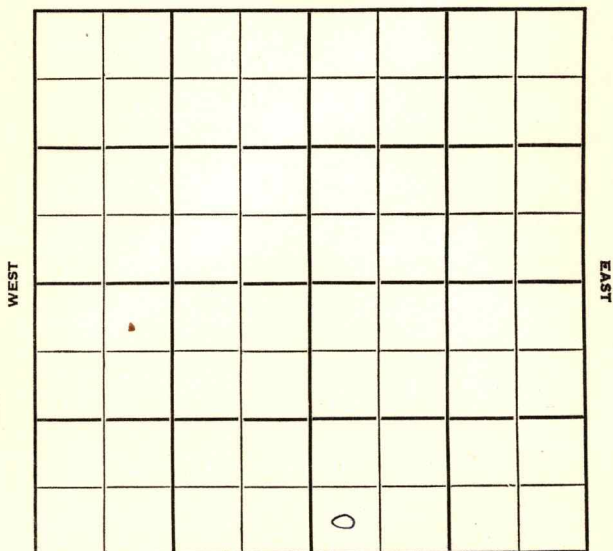

SOUTH

Sec. 28 Twp. 26 R. 16W

Well No. #1 Mellor Farm

Sinclair O & G Company

W. M. Barnett -Contr. Contractor

Wildcat


 Ft. from N. Line

330' Ft. from S. Line

 Ft. from E. Line

330' Ft. from W. Line

SW SW SE

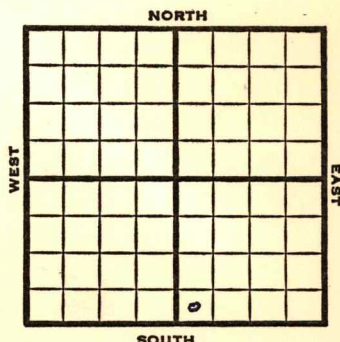

1951 **Elev. 2088'** REPORT

9/26 10" @ 293
Anhy 355
Drlg. 3240 to DST
10/17 D&A TD 4900
10" @ 293
Anhy 355 Cong. 4460
Lans. 4005 Miss. 4472
DST 4472-4515 failed
DST 4485-4505 open 45 min.
Rec. 80' GCM
DST 4505-4545 open 1 hr.
Rec. 67' mud Misner 4553
DST 4553-95 open 1 hr.
Rec. 150' GCM SSO
Viola 4623 Simp. 4479
Arb. 4838-4900 TD
D&A

ABANDONED

