

KANSAS Finney
KANSASSection 16 Township 26 Range 34WWell No. 1 NolanCompany Champlin Ref.Hugoton Pool
NORTH

			0				

SOUTH

KANSAS

Finney

Sec. 16 Twp. 26 R. 34W ✓Well No. #1 Nolan Farm

Champlin Ref. Company

Hugoton Pool


330 Ft. from N. Line

Ft. from S. Line

330 Ft. from E. Line

Ft. from W. Line

NE SW

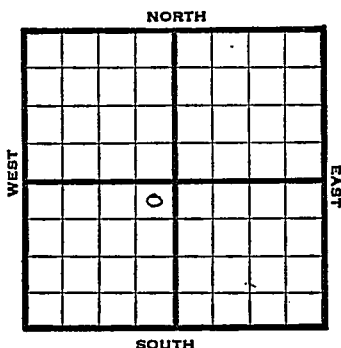

1948

Eli 296 7' REPORT

9/15

8" @ 548'

TD 2734'

5" @ 2734'

Heebner 2488'

Herrington 2518'

Krider 2542'

Windfield 2576'

Ft. Riley 2640'

9/21

168 shots 2686-2714 fsg.

9/29

156 shots 2642-68

120 " 2582-2602

204 " 2530-64 - 37,000 acid

10/6

"

10/13

"

10/19

"

10/27

TD 2734'

5" @ 2734'

Perf 37000 acid

15,000,000 Gas

420# R Pr.

Comp

COMPLETED

Finney County Kansas State

Map No. _____ Sec. 16 Twp. 26 R. 34W

Well No. 1 Nolan

Champlin Ref. _____ Company

FIRST REPORT

Contractor

NE SW

SECTION PLAT

330 Ft. from N. Line

Ft. from S. Line

330 Ft. from E. Line

Ft. from W. Line

Hugoton Pool

Remarks:

8" @ 548 TD 2734 5" @ 2734

Heebner 2488 Herrington 2518

Krider 2542 Winfield 2576

Ft. Riley 2640

Date _____

SEP 15 1948

Scout

Scout **S. J. LEWIS**

Map No. _____ Sec. 16 Twp. 26 R. 34WWell No. 1 Nolan

Champlin Ref. _____ Company _____

COMPLETE _____ Contractor _____

NE SW

E 1,2967
SECTION PLAT330 Ft. from N. Line

_____ Ft. from S. Line

330 Ft. from E. Line

_____ Ft. from W. Line

	0		

Finney County

Location _____

Rig up _____

Drilling and Remarks:

5" C 2734Perf.37000 acid15,000,000 Gas420⁺ RA

RECORD

Cased _____ in., _____ ft.

Sand _____

Gas _____

Oil _____

Total Depth 2734

PRODUCTION

1st 24 hrs. Nat. _____

1st 24 hrs. after shot _____

Gas _____ Cu. Ft.

Dry Hole _____

Abandoned _____

Date

OCT 27 1948 19S. J. LEWIS

Scout