

LAUGHLIN-SIMMONS & CO. OF KANSAS, INC.

Oil Well Elevations and Locations
2121 W. 18th 316-WH3-5351
Wichita, Kansas 67203

10-22-68
DATE

Edwards 21 26s 17w
COUNTY S T R

C 12 NW NE

LOCATION

Glen N. Rupe
OPERATOR

1
NO.

Fisher
FARM


Mr. Glen N. Rupe
222 Brown Building
Wichita, Kansas 67202

Authorized by Faye Leach

Scale

Tel. No. 2125 gr
Elevation
@ Pits

Remarks:

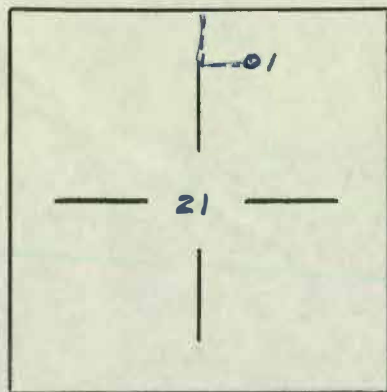

Passed in October

DR. Tammahill
LS Engineer

Minimum Staking Charge:

Elevation Charge:


Extra Time and Mileage:

TOTAL

\$20.00

\$20.00

Sec. 21 T26S R17W

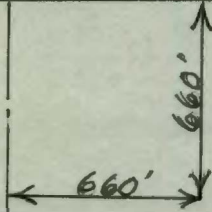

21

This is a true and correct survey
of location Fisher#1 NW NE Sec.21
T26S R17W in Edwards County, Kansas.

Bob Brull
Bob Brull