

## LAUGHLIN-SIMMONS &amp; CO. OF KANS INC.

Oil Well Elevations and Locations

2121 W. 18th 316-WH3-5351

Wichita, Kansas 67203

10-22-68

DATE

Edwards  
COUNTY

22 S 26s T 17w R

C SW NE

LOCATION

Glen N. Rupe  
OPERATOR1  
NO.Fatzer  
FARMMr. Glen N. Rupe  
222 Brown Building  
Wichita, Kansas 67202

Authorized by


Faye Leach

Tel. No.

2117 gr

Elevation

Scale

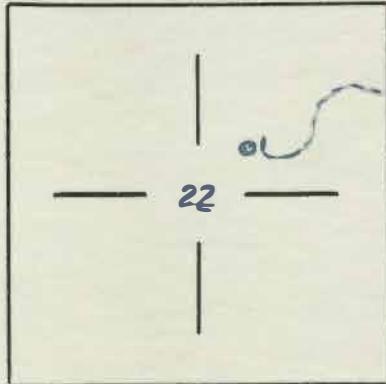

Remarks:

@ Pits.

Bore in October

T. L. Leach

  
DR. L. M. Hill  
LS Engineer

Minimum Staking Charge:

\$20.00

Elevation Charge:

—


Extra Time and Mileage:

\$20.00

TOTAL


6.4

Sec. 22 T26S R17W

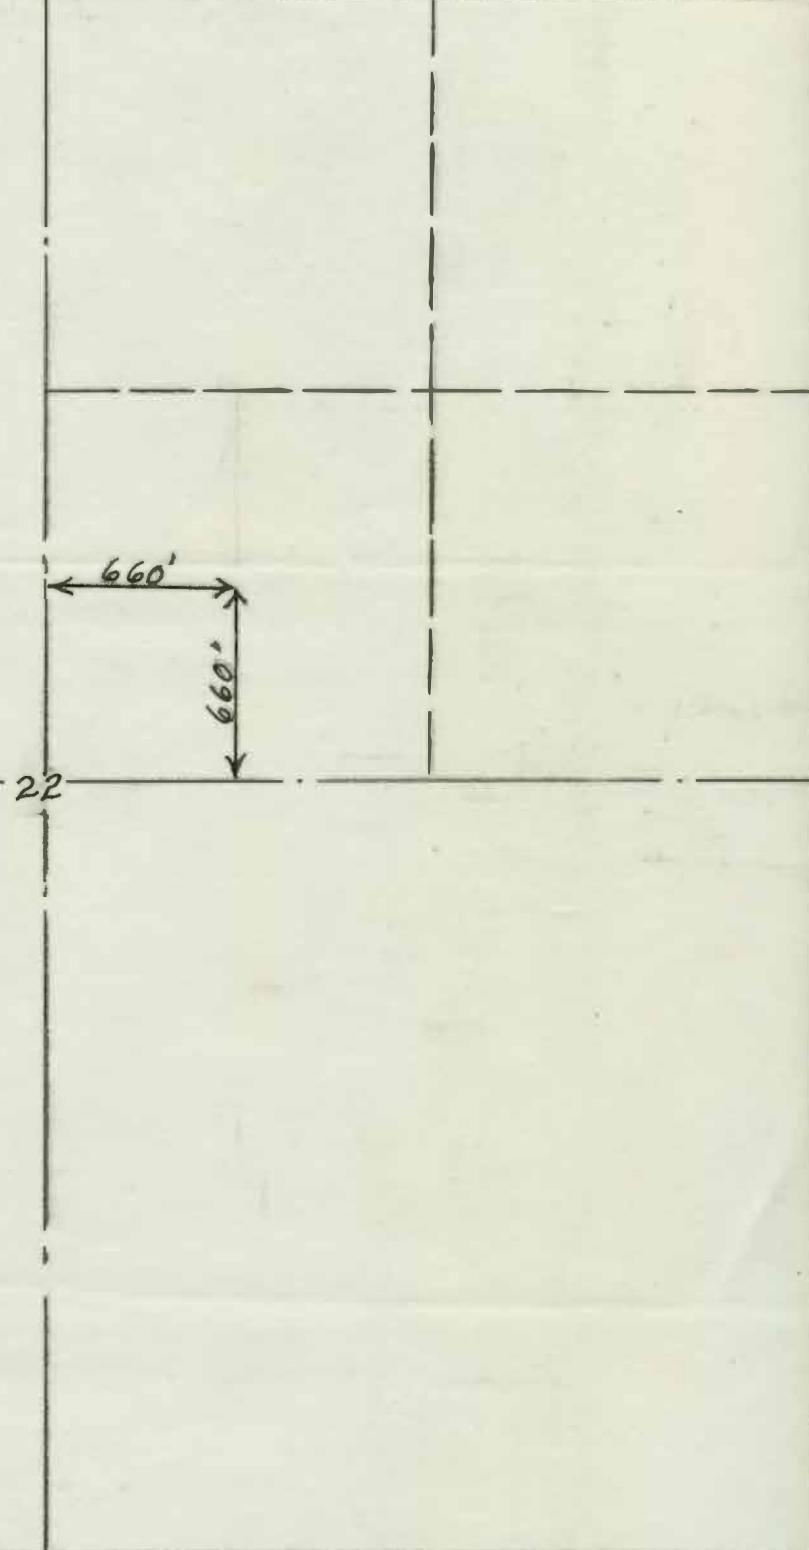

This is a true and correct survey  
of location J. R. Patzer Est. #1  
Sw NE Sec. 22 T26S R17W in Edwards  
County, Kansas.

*Bob Brull*  
Bob Brull

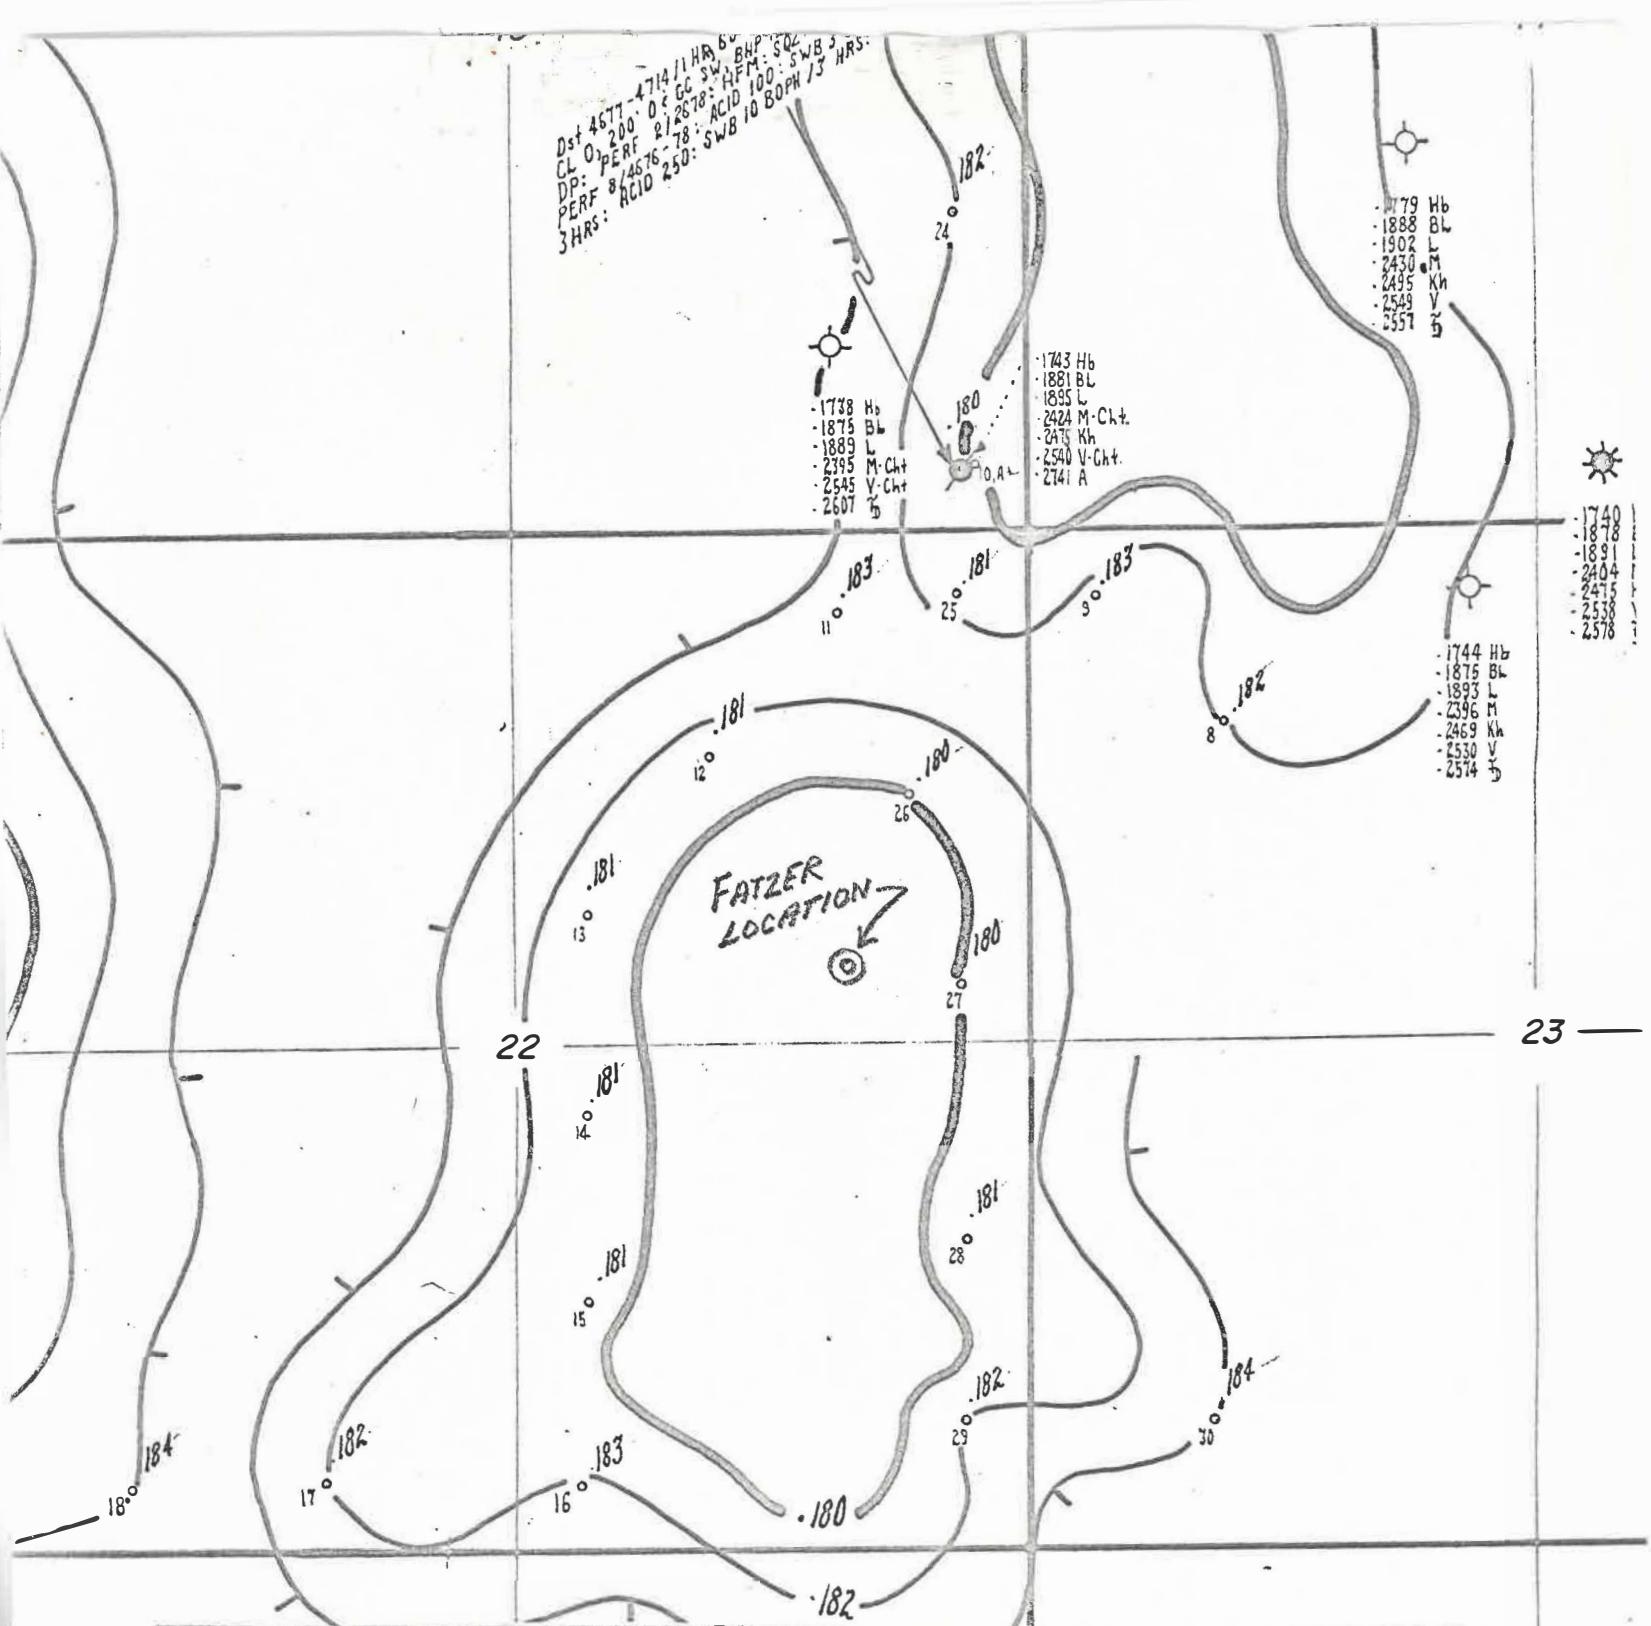

# PROSPECT: *FATZER* COUNTY - EDWARDS

## STATE - KANSAS

FOR

GLEN N. RUPE

BY

# Octo-Tech Exploration Co., Inc.

331 UNION CENTER, WICHITA, KANSAS

CONTOURED ON: *MID-PENNSYLVANIAN* to *ORDOVICIAN* (*Isotime*)

DATUM: SEA LEVEL

CONTOUR INTERVAL = 002 Sec

SCALE: 1" = 1000'

**PARTY CHIEF**

DRAFTED BY: K A H

## **SUPERVISOR**

DATE: 7/13/68

**REVIEWED BY**

— 26 —

1

17

W.