


DX 78-1 EDWARDS

KANSAS

Section 9 Township 26 Range 17W

Well No. 1 Fatzer

Company Aurora & Trans-Era

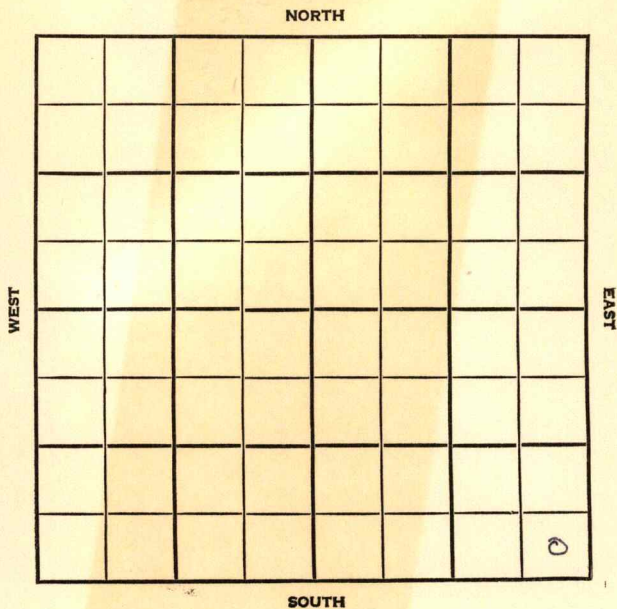

SEC.	TWP.	R.
9	26	17W

WELL NO.

#1 Fatzer

FARM

COMPANY

Aurora & Trans-Era

CONTRACTOR

Trans-Era

Wildcat.

Ft. from N. Line

330

Ft. from S. Line

330

Ft. from E. Line

Ft. from W. Line

M.C.P.C. has S $\frac{1}{2}$ Sec 8 &
NE $\frac{1}{4}$ & N $\frac{1}{2}$ NW $\frac{1}{4}$ Sec 10.

SE SE SE

Carter & Sun - support.

NORTH

WEST

EAST

SOUTH

ELEVATION

XX 2128

REPORT

1955

3/23

Spud 3-20-55

8" @ 357'

WOC

3/30

Heeb 3873', Br lime 4006', Lans 4020'

DST 4090-4111, open $1\frac{1}{2}$ hr rec 110' 0 &
GCM & 2 gal oil, 1270#

DST 4113-25, open 1 hr rec 545' SW,
1485#. Drlg. 4125'. (Ltr-Gilstrap)

4/7

B KC 4374', Miss 4534'

DST 4522'-52' opn 1 3/4 hr, gas in 10 min, 150' sgcm, 1475#

DST 4552'-78' opn 1½ hr, gas in 45 min
rec 105' gcm, 60' wm, 1320# Kh. 4588'

Misener 4607' Viola 4644'

Fishing @ 4809'

(Sct. Ltr.)

4/14

D & A

33

OVER

1955
4/13

Spud 3-20-55 - D&A

TD 4940'

8" @ 357'

Heeb. 3873', Br lime 4006', Lans.
4020'

DST 4090-4111', opn 1½ hrs., rec. XXXX
110' o & gcm, 2 go 1270#

DST 4113-25', opn 1 hr., rec. 545'
sw, 1485#

B KC 4374', Miss 4534'

DST 4522-52, opn 1 3/4 hrs., gas
in 10", 150' sgcm, 1475#

DST 4552-78', opn 1½ hrs., gas in
45", rec. 105' gcm, 60' wm, 1320#

Kh. 4588', Misener 4607', Viola 4692'

Simp. 4823', Arb. 4894'

TD 4940'

Schl Tops: Heeb. 3872', Tor. 3893',
Br lime 4006', Lans. 4020', B KC 4374',
Cherokee 4478', Ch. Miss 4519', Kh.
4591', Kh. sd 4615', Viola 4694',
Simp. 4794', Arb. 4874'

TD 4940'

D&A

~~ABANDONED~~

ABANDONED

FIRST REPORT

330	Ft. From	S	Line	SE
330	Ft. From	E	Line	Quarter

1st. Report

Completion

Remarks Carter & Sun - support
Trans-Era - Contr.

Spudding Date 3-20-55

Drig. Data Wildcat

MCPC has S $\frac{1}{2}$ sec. 8 and NE $\frac{1}{4}$ & N $\frac{1}{2}$ NW $\frac{1}{4}$ sec. 10
8" @ 357 WOC

FABEN GILSTRAP

County Edwards State Kansas
 Sec. 9 (Blk.) 26 (Sur.) 17W Map No. _____
 Operator Aurora & Trans-Era
 Well No. 1 Farm Fatzer
 Elev. 2128 Location SE SE SE

330 Ft. From S Line SE330 Ft. From E Line Quarter

1st. Report _____

Completion APR 13 1955Remarks WildcatTrans-Era - Contr.Spudding Date 3-20-55Drlg. Data D & A TD 49408" @ 357 Heeb. 3873 Br. lime 4006Lans. 4020 DST 4090-4111 open 1½ hr.Rec. 110' o & gcm 2 go 1270# DST 4113-25 open 1 hr. Rec. 545' sw 1485#B KC 4374 Miss. 4534 DST 4522-52open 1 3/4 hr. gas in 10 min. 150' sgcm1475# DST 4552-78 open 1½ hr. gas in45 min. Rec. 105' gcm 60' wm 1320#Kh. 4588 Misener 4607 Viola 4692Simp. 4823 Arb. 4894 TD 4940SCHLUMBERGER TOPS:Heeb. 3872 Tor. 3893 Br. lime 4006Lans. 4020 B KC 4374 Cherokee 4478Ch. Miss. 4519 Kh. 4591 Kh. sd. 4615

FABEN GILSTRAP

Drig. Data

Viola 4694

Simp. 4794

Arb. 4874

TD 4940

D & A
Misc.
Pierce Map
France Map
Tracings
Land Wall Map
Land Small Map
Scout Cards

APR 20 1955