
Edwards

FORM 51-5M-6-29-PETROL

Map No. KANSAS Sec. 21 Twp. 26 R. 17 W

Well No. 1 Johnson Farm

Kelly Oil Company

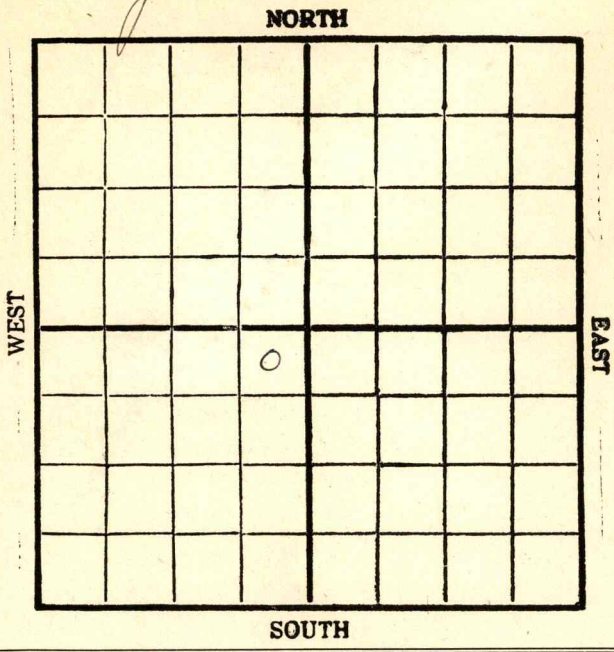

Location

Drilling Remarks

Rig Up

Drilling Remarks

2755

RECORD

Cased ____ in. ____ ft.

Sand

Gas

Oil

Total Depth

PRODUCTION

1st 24 hrs. Nat.

1st 24 hrs. after shot

Gas ____ cu. ft.

Dry Hole

Abandoned

Edwards

Form 252A—5M—10-26—24951

Map No. KANSAS Sec. 21 Twp. 26 R 17W

Well No. 1 Johnson Farm


Kelly Oil Company

330 Ft. from N. Line

Ft. from S. Line

330 Ft. from E. Line

Ft. from W. Line

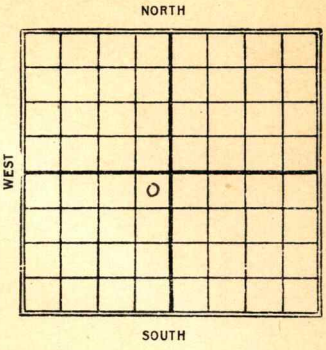

1929

Date	REPORT
10/23	Rig Rig (rotary)
10/30	Right up.
11/6	
11/13	40' S.P.
11/20	Rlg 800'
11/27	" 1525
12/4	" 1700
12/11	" 2450'
12/18	" 2675'
12/23	" 2860'
12/30	" 3230'
1930	
1/8	" 3420'
1/15	" 3585'
1/22	SD 3585'
1/29	drlg 3780'
2/5	" 3865
2/12	" 4120'
2/19	" 4200
2/26	" 4375
3/5	" 4515

3/2- Drlg. 4540-
8"-4487'

3/19- 4540- Drlg out cement.

3/26- Drlg. 4635 show gas
4541

4/2- Drlg 4779

4/9- " 4855'

4/16- " 4925' 6"-4907

4/23- " 5010 ~~4780~~ 5002

4/30- T.D. 5095
Abandoned

Edwards

Form 252A—5M—11-29—38055

Map No. KANSAS Sec. 21 Twp. 26 R. 17W

Well No. 1-J Johnson Farm


J Kelly Oil Company

330 Ft. from N. Line

Ft. from S. Line

330 Ft. from E. Line

Ft. from W. Line

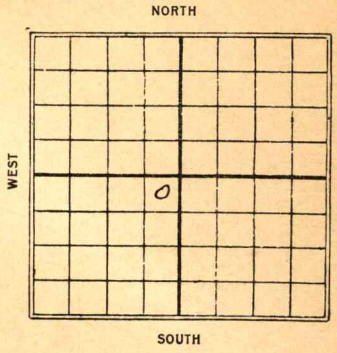

1930

Date	REPORT OWDD No Record
5/7	Old T.D. 5095'
	VIR 6" - 5095'
5/14	Drlg. 5150'
5/21	Sand 5210-20' HFW
	TD 5220
	Dry & Abandon

Form 26-1M Bks. 9-28

Edwards

Map No. KANSAS Sec. 21 Twp. 26 R. 12 W


84

Well No. 1 J. Johnson

Skelly Oil Company

Contractor

SECTION PLAT

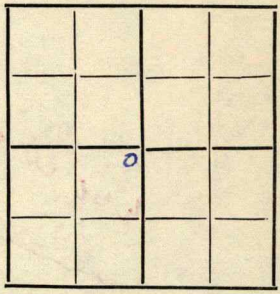

330 Ft. from N. Line

Ft. from S. Line

330 Ft. from E. Line

Ft. from W. Line

FIRST REPORTS

Location

Rig up

Drilling and Remarks:

Building rig

Rotary

RECORD

Cased in., ft.

Sand

Gas

Oil

Total Depth

PRODUCTION

1st 24 hrs. Nat.

1st 24 hrs. after shot

Gas Cu. Ft.

Dry Hole

Abandoned

Date

OCT 23 1929

192

S. J. LEWIS Scout

Form 26—LM Bks. 3-28

Map No. KANSAS Sec. 21 Twp. 26 R. 17 W


84

Well No. J. Johnson

Skelly Oil Co. Company

Contractor

SECTION PLAT

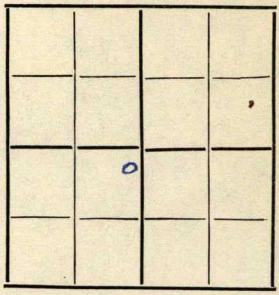

330 Ft. from N. Line

Ft. from S. Line

330 Ft. from E. Line

Ft. from W. Line

ABANDONED

Location

Rig up

Drilling and Remarks:

RECORD

Cased in., ft.

Sand

Gas

Oil

Total Depth 5095

PRODUCTION

1st 24 hrs. Nat.

1st 24 hrs. after shot

Gas Cu. Ft.

Dry Hole

Abandoned

Date

APR 30 1930 192

S. J. LEWIS Scout

Form 26—1M Bks.—9-26

Edwards


Map No. KANSAS Sec. 21 Twp. 26 R. 12 W

Well No. 1 Johnson

Kelly Oil Company

Contractor

SECTION PLAT

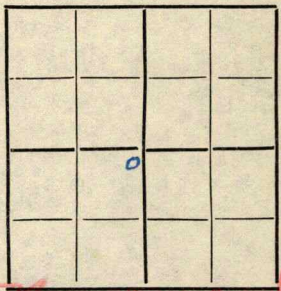

330 Ft. from N. Line

Ft. from S. Line

330 Ft. from E. Line

Ft. from W. Line

OWWO

No Record

Location

Rig up

Drilling and Remarks:

Old TD 5095

5095 4½ 6"

RECORD

Cased in., ft.

Sand

Gas

Oil

Total Depth

PRODUCTION

1st 24 hrs. Nat.

1st 24 hrs. after shot

Gas Cu. Ft.

Dry Hole

Abandoned

Date

MAY 7 1930 192

S. J. LEWIS Scout

Form 26—1M Bks—9-28


Map No. KANSAS Sec. 21 Twp. 26 R. 17W

Well No. 84 J. D. Lanson

Sec 4 Oil Company

Contractor

SECTION PLAT

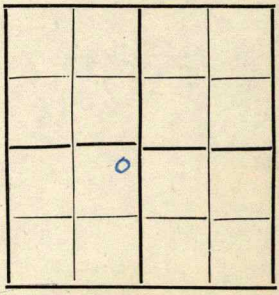

330 Ft. from N. Line

Ft. from S. Line

330 Ft. from E. Line

Ft. from W. Line

ABANDONED

Location

Rig up

Drilling and Remarks:

Sand 5210-20
A P W

RECORD

Cased in., ft.

Sand

Gas

Oil

Total Depth 5220

PRODUCTION

1st 24 hrs. Nat.

1st 24 hrs. after shot

Gas Cu. Ft.

Dry Hole

Abandoned

Date

MAY 21 1930 192

S. J. LEWIS Scout