


SECTION 35 TOWNSHIP 26S RANGE 17W

WELL NO. #1 Fisher

COMPANY D.R. Lauck

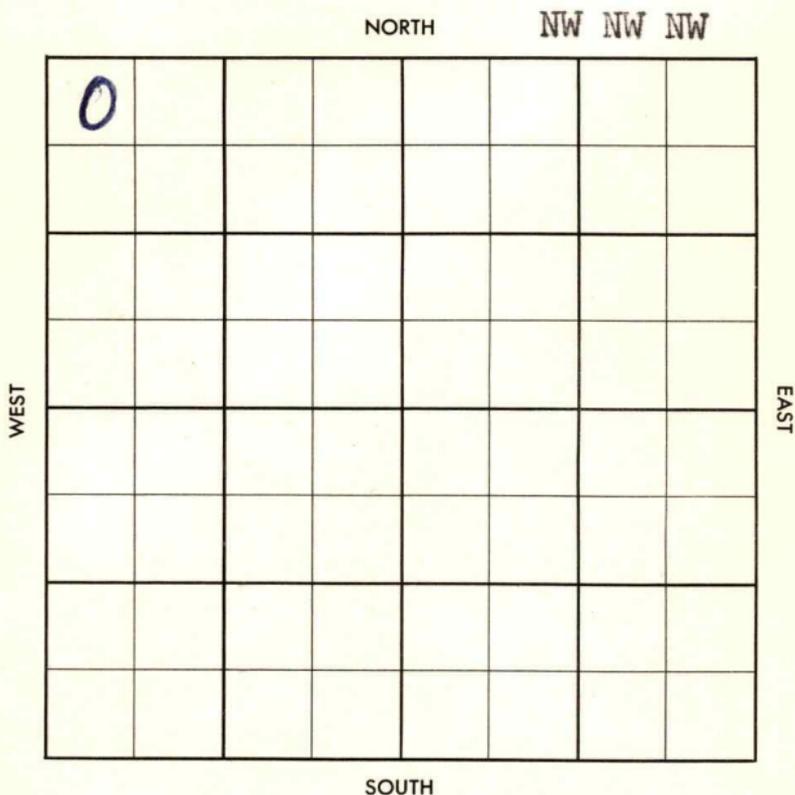

County Edwards

Elev. 2127 DF

Sec. 35 Twp. 26

Rge. 17W

Company D. R. Lauck

Farm Name Fisher

No. 1

TOPS	DEPTH	LOG	DATUM
Anh.			
Tp.			
H.	3894	3894	
Tr.			
Dg.		3934	
Bl.	4035	4036	
L.	4053	4054	
K.C.			
B.K.C.		4406	
Ce.			
C.			
M.	4557	4554	
M.			
K.		4576	
Mz. <u>K 5d</u>		4596	
Mq.			
V.		4644	
S.			
S.			
A.			
R.			
PE.			
G.			
TD.	4755	4756	

Loc. in Sec. NW NW NW

Geol. _____

Contr. _____

Co. Tools _____

Pool _____

Wildcat

0		
ABANDONED		
SEP	11	57

Date Comm. 8/21/57

8" @ 236 w/250, Drlg 2865 Gulf-(DHM)

Texas (DHM) - SEP 4 '57 D 4580 SEP 11 '57

D 6 A

4594-4610 30' M & BHP 552/20

WILDCAT

25B-0

FORM 513 SUNRAY

County Edwards Elev. _____
 Sec. 35 Twp. 26 Rge. 17W
 Company D. R. Lauck
 Farm Name Fisher No. 1

TOPS	DEPTH	LOG	DATUM	Loc. in Sec.												
Anh.				NW NW NW												
Tp.																
H.																
Tr.																
Dg.																
Bl.																
L.				Geol. _____												
K.C.				Contr. _____												
B.K.C.				Co. Tools _____												
Ce.				Pool _____												
C.				Wildcat												
M.				<table border="1"> <tr> <td>o</td> <td></td> <td></td> </tr> <tr> <td colspan="3">FIRST REPORT</td> </tr> <tr> <td></td> <td></td> <td></td> </tr> <tr> <td colspan="3">AUG 28 '57</td> </tr> </table>	o			FIRST REPORT						AUG 28 '57		
o																
FIRST REPORT																
AUG 28 '57																
M.																
K.																
Mz.																
Mq.																
V.																
S.																
S.																
A.																
R.																
PE.																
G.																
T.D.																

Date Comm. 8/21/57
8" @ 236 w/250, Drlg 2865 Gulf-(DHM)
Texas (DHM)

(Handwritten red scribbles)

Co.
Lse.
No.
Sec.
T.
R.