


Section 17 Township 26 Range 38W

Well No. 1 Johnston

Company Stanolind

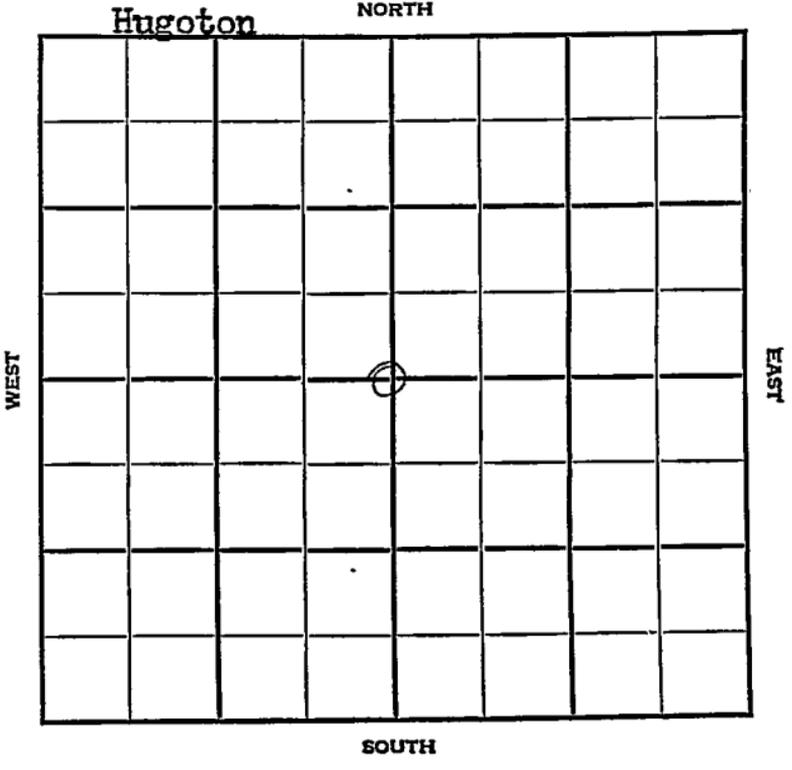

Sec. 17 Twp. 26 R. 38W

Well No. #1 Johnston Farm

Stanolind Company

Hugoton Pool


2640' Ft. from N. Line

Ft. from S. Line

2640' Ft. from E. Line

Ft. from W. Line

C Sec.

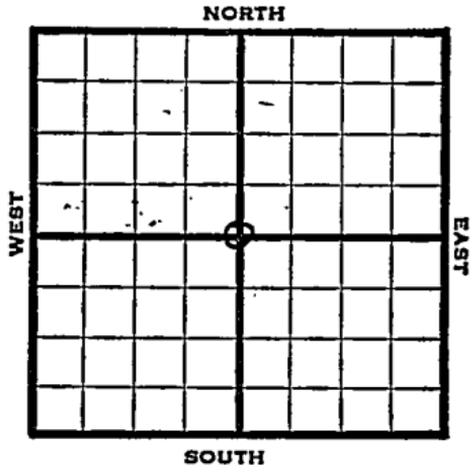

1948 El. 3275' REPORT

3/3	Location
3/10	"
3/17	"
3/24	"
3/31	"
4/7	"
4/14	10" @ 647' Drig. 1564'
4/21	7" @ 2465' TD 2482'
4/28	"
5/5	220' of 5" liner @ 3676'
5/12	16,500 acid.
5/19	"
5/26	"
6/1	"
6/9	"
6/16	FD 2676' 7" @ 2465' 220' of 5" liner @ 2676' 16500 acid 29 M Gas 420# R Pr.

Comp COMPLETED

Map No. _____ Sec. 17 Twp. 26 R. 38W

Well No. 1 Johnston

Stanolind Company

WEST BEND Contractor

C Sec.


SECTION PLAT

2640 Ft. from N. Line

_____ Ft. from S. Line

2640 Ft. from E. Line

_____ Ft. from W. Line

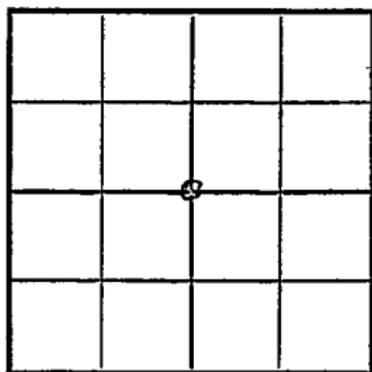

Kearny County

Location X

Rig up _____

Drilling and Remarks:

RECORD

Cased _____ in., _____ ft.

Sand _____

Gas _____

Oil _____

Total Depth _____

PRODUCTION

1st 24 hrs. Nat. _____

1st 24 hrs. after shot _____

Gas _____ Cu. Ft.

Dry Hole _____

Abandoned _____

Date

MAR 3 1948 19

S. J. LEWIS Scout

Map No. _____ Sec. 17 Twp. 26 R. 38W

Well No. 1 Johnston

Stanolind Company

COMPLETE Contractor

C Sec.


E1.3275
SECTION PLAT

2640 Ft. from N. Line

_____ Ft. from S. Line

2640 Ft. from E. Line

_____ Ft. from W. Line

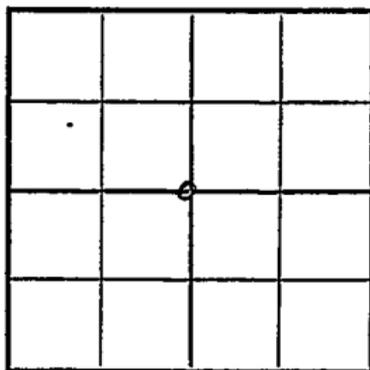

Kearny County

RECORD

Location _____

Cased _____ in., _____ ft.

Rig up _____

Sand _____

Drilling and Remarks:

Gas _____

7" @ 2465

Oil _____

220' of 5" liner

Total Depth 2676

@ 2676

PRODUCTION

11500 @ 2676

1st 24 hrs. Nat. _____

2911 Gas

1st 24 hrs. after shot _____

420 R/P*

Gas _____ Cu. Ft.

Dry Hole _____

Abandoned _____

Date

JUN 16 1948 19

S. J. LEWIS Scout