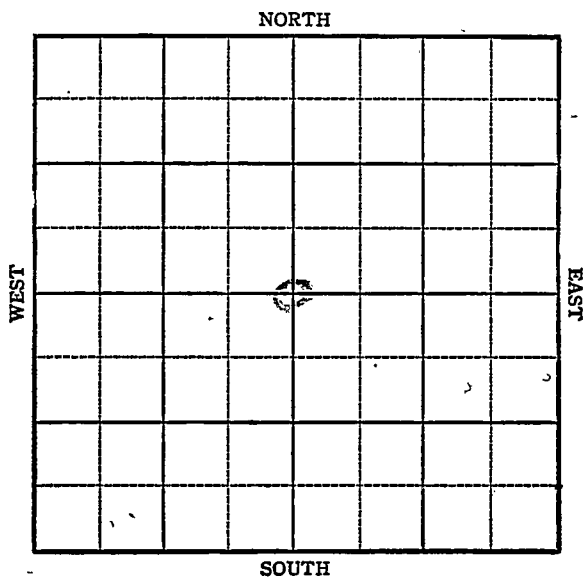


KANSAS

Finney County

FORM 51 5M BRIX

Section 17 Township 26S Range 34WWell No. #1 Satorius #1 KeiserCompany Helmerick & Payne

KANSAS

Haskell

Finney

Sec. 17 Twp. 26 R. 34WWell No. #1 Saturnus Yeiser Farm

Helmerick & Payne

Company

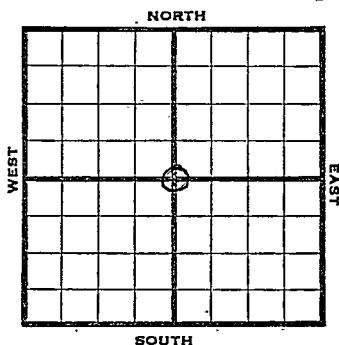
Hugoton

2640 Ft. from N. Line

Ft. from S. Line

2640 Ft. from E. Line

Ft. from W. Line



C Sec.

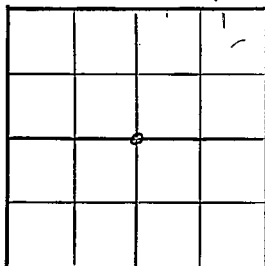
1944 ELEV 2978 REPORT

12/6	Location					
12/14	"					
12/21	"					
12/27	RURT					
1945						
1/3	"					
1/10	Drlg 900					
1/17	10"	@ 865	5"	@ 2695	TD	Rust
1/26	"	"	"	"	"	"
1/30	"	"	"	"	"	"
2/7	"	"	"	"	"	"
2/14	"	"	"	"	"	"
2/21	"	"	"	"	"	"
2/28	TD 2699	Rip Csg	5000	acid		
3/7	Total of 17,000 acid					
3/14	"	"	"	"		
3/23	"	"	"	"		
3/29	"	"	"	"		
4/5	"	"	"	"		
4/11	5" @ 2695 Rip Csg.					
	TD 2699					
	17500 acid.					
	10,850,000 Gas					
	426# R Pr.					

COMPLETED

Pool Name HugotonMap No. A1 M Sec. 17 Twp. 26 R. 34WWell No. 1 SatoriumHelmerick & Payne CompanyFIRST REPORT ContractorC Sec

SECTION PLAT

2640 Ft. from N. Line Ft. from S. Line2640 Ft. from E. Line Ft. from W. LineFinney CountyLocation XRig up

Drilling and Remarks:

RECORD

Cased in., ft.Sand Gas Oil Total Depth

PRODUCTION

1st 24 hrs. Nat. 1st 24 hrs. after shot Gas Cu. Ft.Dry Hole Abandoned

Date

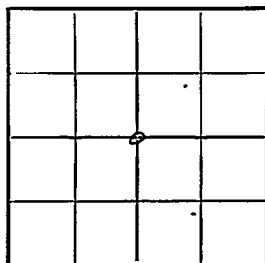
DEC 6 1944 19S. J. LEWIS Scout

Pool Name HugotonMap No. WM Sec. 17 Twp. 26 R. 34WWell No. 1 YeiserHelmerick & Payne Company**CORRECTION**

Contractor

C Sec

SECTION PLAT

2640 Ft. from N. Line Ft. from S. Line2640 Ft. from E. Line Ft. from W. LineFinneyLocation Rig up

Drilling and Remarks:

reported as

#1 Satorius

RECORD

Cased in. ft.Sand Gas Oil Total Depth

PRODUCTION

1st 24 hrs. Nat. 1st 24 hrs. after shot Gas Cu. Ft.Dry Hole Abandoned

Date

JAN 10 1945

19

S. J. LEWIS

Scout

Kansas

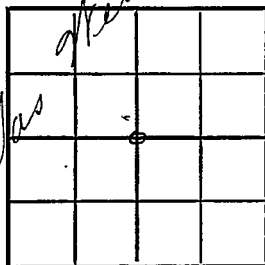
Pool Name HugotonMap No. No map Sec. 17 Twp. 26 R. 34WWell No. 1 YeiserHelmerick & Payne

Company

COMPLETED

Contractor

C. sec.

SECTION PLAT2640 Ft. from N. Line

Ft. from S. Line

2640 Ft. from E. Line

Ft. from W. Line

Finney

Location

Rig up

Drilling and Remarks:

5' to 2685'Rip csg17500 acw/c10,860,000 Gas#26 R P E**RECORD**

Cased _____ in., _____ ft.

Sand _____

Gas _____

Oil _____

Total Depth 2689**PRODUCTION**

1st 24 hrs. Nat. _____

1st 24 hrs. after shot _____

Gas _____ Cu. Ft.

Dry Hole _____

Abandoned _____

Date

APR 11 194519S. J. LEWIS

Scout