

**LAUGHLIN-SIMMONS & CO. OF KANSAS, INC.**

OILWELL ELEVATIONS AND LOCATIONS

2121 W. 18TH STREET

(313) W 3-5351

WICHITA, KANSAS 67203

11-12-71

DATE

Edwards

25

26s

18w

C NW NW

COUNTY

S

T

R

LOCATION

Glen Rupe & Century Oil

OWDD Brown

OPERATOR

NO.

FARM


ELEVATION: 2162 Gr.

Mr. Glen Rupe  
925 Olive Garvey Building  
Wichita, Kansas 67202

NOV 15 1971

SCALE: 2" = 1 mile

4 miles TO Hwy.

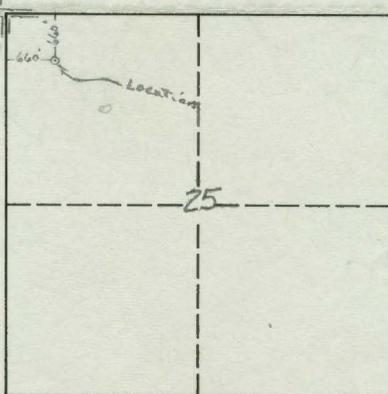

Please note!

Set 5' STK on same spot that was reported on well drilled as Southland - Royalty #1. Falls on slightly sloping area in rolling, sandy wheat field.

~~STAKING CHARGE:~~ \$ 75<sup>00</sup>


~~EXTRA TIME & MILEAGE:~~ \_\_\_\_\_

~~OPERATION CHARGE:~~ \_\_\_\_\_

TOTAL: \$ 75<sup>00</sup>

-special Trip

E. L. Leube  
L-S ENGINEER

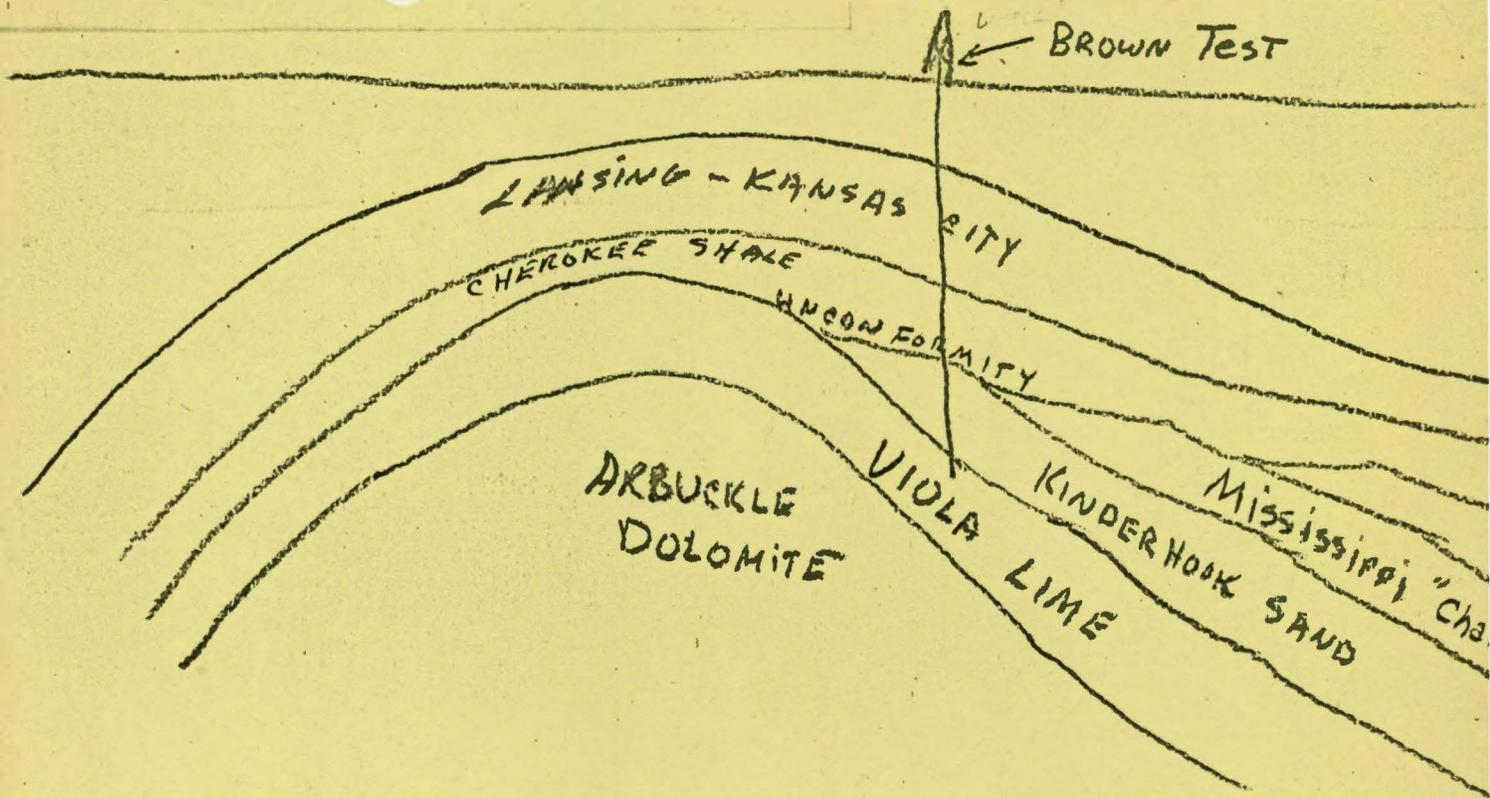

The above cross section depicts the BROWN Test and the underlying formation. At a -2410' we encountered the Kinderhook Sand rather than the hoped for Mississippi formation which as shown in the cross section had been eroded from the Top of the Kinderhook Sand. We feel that our acreage is still valuable and will merit paying delay renta in the future or drilling another test Well.

M 2360  
v 2437

R 18 W

(A) TK-1139

M-2373 L-1851 NW 2129  
Ch 2346

(B) 1129  
NOT PENETRATED

1154 (E)  
M-2447  
V-2529

(D) 1134  
NOT PENETRATED

(C) 1143  
NOT PENETRATED

216 KB

TKLM-  
~~1851~~  
Lans 4860 (1894)  
B/KC 4410 (24325)

27

26

T  
26  
S 240  
261


-2400

(F) 1156  
M-2450

34

35

36

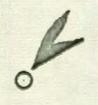

Brown #1  
C NW 4  
25-26-18

J.C. Musgrove  
793 9152

(G) 1155  
M-2432  
V-2598  
2-1930

and  
herstein

11-29 MIRT

11-30 Spud

12-1 Set 8 5/8 @ 328 with 270 SX - 2% CaCl  
2% get Plug down @ 11:30 PM 11/3012-2  $\phi$  1975 Anh 1179-120512-3  $\phi$  274512-4  $\phi$  3200 Foraker 3031 (865) Wabamsee 3174 (1008)  
Tankio 3254 (4088)DST # 1 3235-60 / 30-30-36-30  
String blue dec to weak  
Rec 408' GIP, 240' MW  
FP 33-66 116-125  
851-775 #12-6  $\phi$  3660 vic 3212-7  $\phi$  4045 Hb 3926 (1760) Tor 3940 (1774)

Dg 3957 (1791) BL 4050 (1884) L 4060 (1894)

DST # 2 4084-4121 / 45-45-45-45 wk blue thru, Rec 10' 510's 60' 110'

120' gassy mud with splr oil, 120' MW, FP 110-110 110-121 #

SIP 1206-1130 #

12-8  $\phi$  413512-9  $\phi$  434012-10  $\phi$  4515 B/KC 4410 (2243)

12-11 Kinderhook 4583 (2413) DST # 3 4586-96 45-45-45-45

~~12-12~~ String blue Rec 300 GIP, 10' GIP

12-12 Viola 4638 (2471) FP 28-28, 28-28 BHP 362-324 #

Th-4682 Plug @ 600 / 40SX cut

@ 300 / 40SX cut

D 1/2 A

@ 40 / 10SX cut 1/2 SX hulls Plugger. J.R. Bit.

~~Plug~~ Job find  
@ 230 PM