


RUPE OIL COMPANY, INC.
BROWN LEASE
NE.1/4, SECTION 20, T26S, R18W
EDWARDS COUNTY, KANSAS


*Ingress and egress to location as shown on this plat is per usage only and may not be legally opened for public use. Contact landowner, tenant and county road department for access.

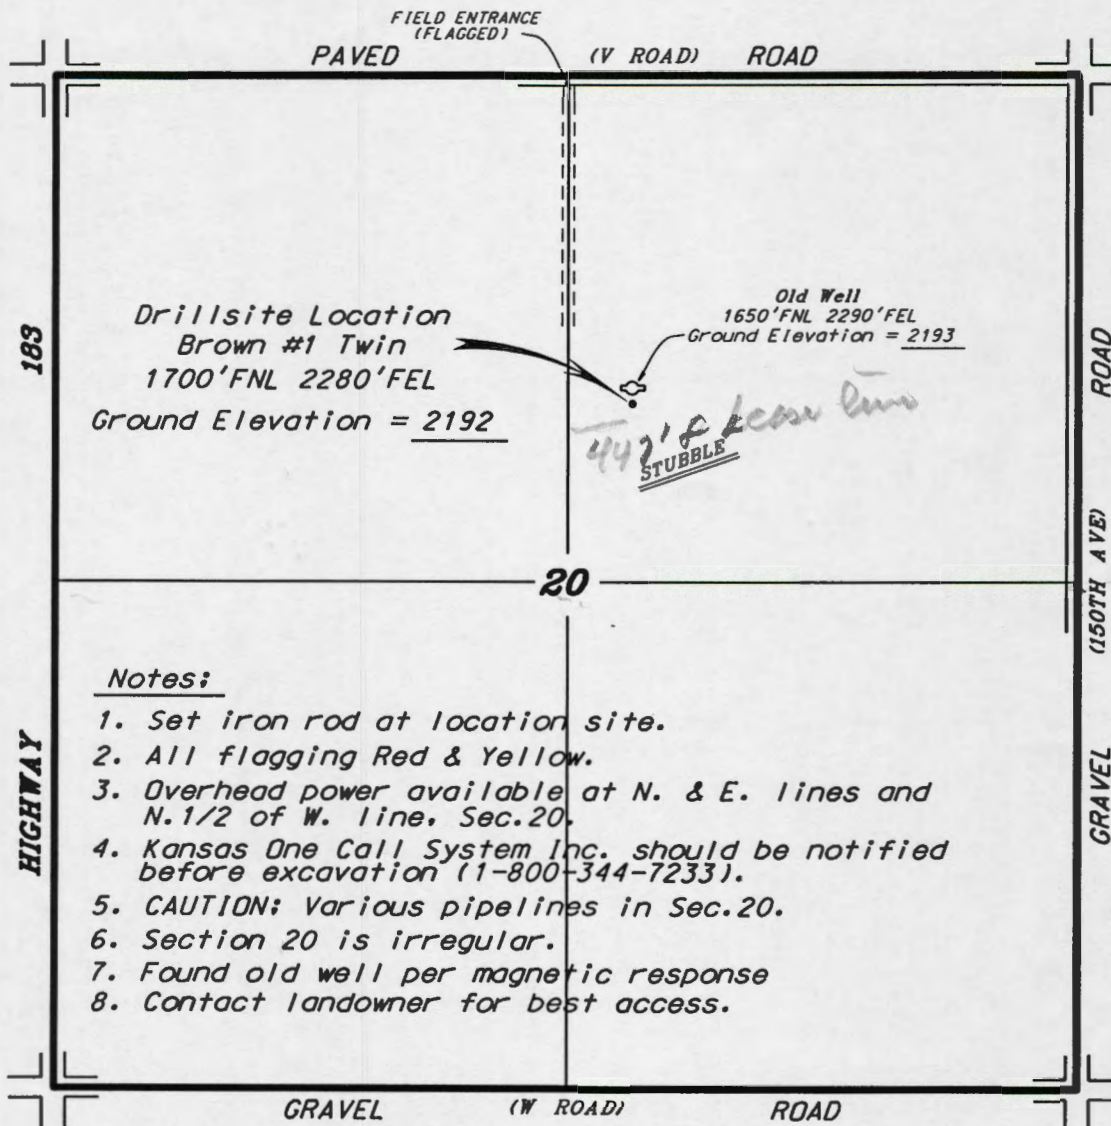

SCALE 1" = 1000'

2640
 2193

 447

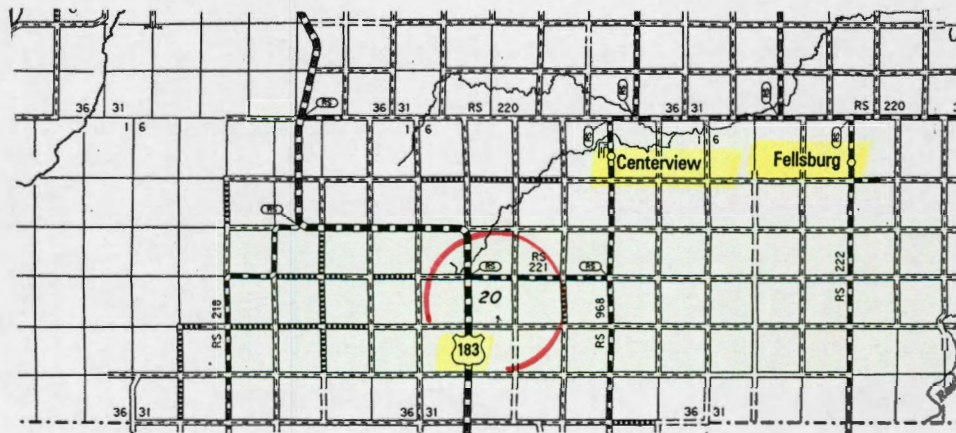

* Controlling data is based upon the best maps and photographs available to us and upon a regular section of land containing 640 acres.
 * Approximate section lines were determined using the normal standard of care of oilfield surveyors practicing in the state of Kansas. The section corners, which establish the precise section lines, were not necessarily located, and the exact location of the drillsite location in the section is not guaranteed. Therefore, the operator securing this service and accepting this plat and all other parties relying thereon agree to hold Central Kansas Oilfield Services, Inc., its officers and employees harmless from all losses, costs and expenses and said entities released from any liability from incidental or consequential damages.
 * Elevations derived from National Geodetic Vertical Datum.

Date April 25, 2008



W. R. 18 W. 20' 10 MI. TO U.S. 54 COLDWATER 33 MI. 472 (GREENSBURG NE) 6159 III NE 473 474 17'30"

SCALE 1:24000

1 1000 0 1000 2000 3000 4000 5000 6000 7000 FEET

1 5 0 1 KILOMETER

CONTOUR INTERVAL 5 FEET
DATUM IS MEAN SEA LEVEL

GN MN
9 1/2°
11' 169 MILS

ID 1972 MAGNETIC NORTH
IN AT CENTER OF SHEET

THIS MAP COMPLIES WITH NATIONAL MAP ACCURACY STANDARDS
FOR SALE BY U. S. GEOLOGICAL SURVEY, DENVER, COLORADO 80225, OR WASHINGTON, D. C. 20242
AND BY THE STATE GEOLOGICAL SURVEY LAWRENCE KANSAS 66044

QUADRA



CENTERVIEW

C. KING

9.19.68

C. KING

9.19.68

C. KING

C. KING

