

State of Kansas



State Corporation Commission

CONSERVATION DIVISION

(Oil, Gas and Water)

245 North Water
WICHITA, KANSAS 67202

August 23, 1977

REC'D AUG 24 1977

WELL PLUGGING AUTHORITY

Well No.	1
Lease	Robert McLean
Description	SW SE NW Sec. 8-26-18W
County	Edwards
Total Depth	4760
Plugging Contractor	Halliburton Cementing Co.


Rupe Oil Co., Inc.
Box 2273, 434 Ohio
Wichita, Kansas 67201

Gentlemen:

This is your authority to plug the above subject well in accordance with the Rules and Regulations of the State Corporation Commission.

This authority is void after 90 days from the above date.

Yours very truly,

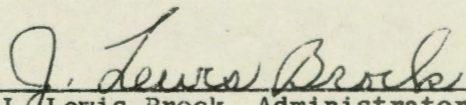
J. Lewis Brock, Administrator


Mr. William T. Owen, P.O. Box 369, Pratt, Kansas 67124
is hereby assigned to supervise the plugging of the above named well.

STATE OF KANSAS
STATE CORPORATION COMMISSION

WELL PLUGGING RECORD

Give All Information Completely
Make Required Affidavit
Mail or Deliver Report to
Conservation Division
State Corporation Comm.
245 North Water
Wichita, KS 67202

Edwards County, Sec. 8 Twp. 26 S Rge. 18 E/W
Location as "NE/CNW/SW" or footage from lines
SW SE NW
Lease Owner G. N. Rupe Etal
Lease Name Robert McLean Well No. 1
Office Address P. O. Box 2273, Wichita, Kansas 67201
Character of Well (Completed as Oil, Gas or Dry Hole) Dry

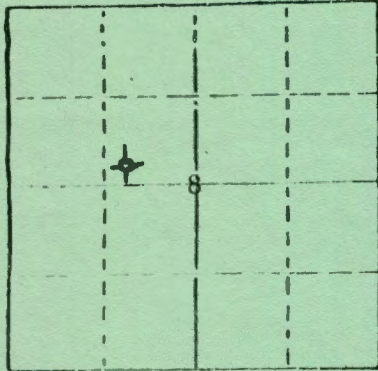

Locate well correctly on above Section Plat

Date Well completed August 19, 1977
Application for plugging filed August 19, 1977
Application for plugging approved August 23, 1977
Plugging commenced August 19, 1977
Plugging completed August 20, 1977
Reason for abandonment of well or producing formation dry

If a producing well is abandoned, date of last production 19

Was permission obtained from the Conservation Division or its agents before plugging was commenced? yes

Name of Conservation Agent who supervised plugging of this well William T. Owen
Producing formation _____ Depth to top _____ Bottom _____ Total Depth of Well 4760
Show depth and thickness of all water, oil and gas formations.

OIL, GAS OR WATER RECORDS

CASING RECORD

FORMATION	CONTENT	FROM	TO	SIZE	PUT IN	PULLED OUT
				8 5/8" Set	@ 345'	none

Describe in detail the manner in which the well was plugged, indicating where the mud fluid was placed and the method or methods used in introducing it into the hold. If cement or other plugs were used, state the character of same and depth placed, from _____ feet to _____ feet for each plug set.

Spot 1st Plug at 500' with 40 sacks Cement;
2nd Plug at 300' with 20 sacks Cement;
at 40' to Ground Level 12 sacks Cement;
Plugged Rathole with 3 sacks cement

(If additional description is necessary, use BACK of this sheet)

Name of Plugging Contractor Halliburton Cementing Co.,
Wichita, Kansas

STATE OF Kansas COUNTY OF Sedgwick
John J. Cecil, Jr. (employee of owner) or _____

of the above-described well, being first duly sworn on oath, says: That I have knowledge of the facts, statements, and matters herein contained and the log of the above-described well as filed and that the same are true and correct. So help me God.

(Signature)

John J. Cecil, Jr.
John J. Cecil, Jr.

1216 Roosevelt (Address)

Great Bend, Kansas August 19 77

SUBSCRIBED AND SWORN TO before me this 23rd day of

Faye W. Leach
Faye W. Leach

Notary Public.

My commission expires September 16, 1977

*mailed original
State Corp. Commission
8/21/77
copy to Wm. P. Higgins
8/21/77
copy G. I. 8/21/77*